

7-26-50

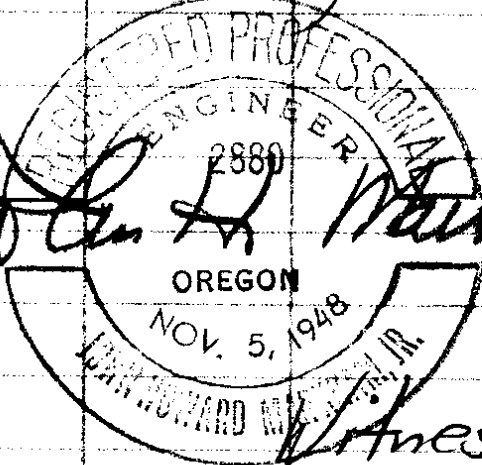
• $\frac{1}{4}$ Section Corner 4 and 9
T29S, R5W W.M. as determined
by one proportionate measure-
ment.

• At corner point set $\frac{3}{4} \times 30"$
I.P. 20" in ground.
from which

• An Alder 13" diam. bears S86W,
25.4' dist. mkd. $\frac{1}{4}$ S9, T29S,
R5W, 2880, B.T.

A log house bears N57E,
270 $\frac{1}{2}$ ' dist. to door.

This corner lies 8.0' North
of creek in large opening.


Howard W. Vaughn, Jr.
Witness.

Geo. Vaughn.

Work done for Storer Lbr Co.

40/259-2