

7-22-50

Section Corner 2-3-10-11

- T295, R5W, W.N. as determined from remains of original B.T.

- B.O. 12" diam. bears  $N87\frac{1}{2}^{\circ}E$  240' dist. I rescribe 53.


- W.O. 12" diam bears  $S20^{\circ}E$  22' dist. I remark this original B.T. S11 2880 B.T.

' At corner point fd.  $5^{\circ} \times 5^{\circ} \times 5^{\circ}$  stone.

from which

A W.O. 12" diam. bears  $S3W$  345' dist. mkd. S10 2880 B.T.

This corner lies at the head of a steep draw, in a grassy opening. A 40' rock ledge bears  $N30W$  130.0' dist. from cor.

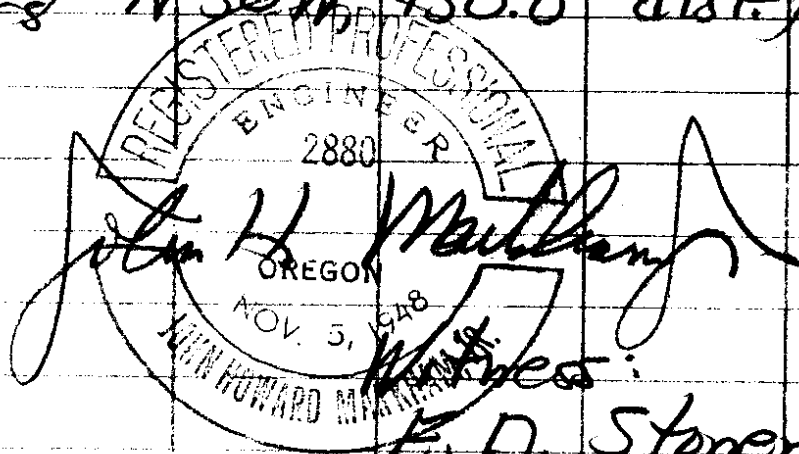

Witness:

E. D. Stonerod  
Geo. Vaughn.

Work done for Stonerod Lbr. Co.

40/259-3