


COUNTY SURVEYORS FILE DATA
DO NOT REMOVE FROM OFFICE

SECTION
19
Geo. just underneath

COUNTY SURVEYOR'S OFFICE
DOUGLAS COUNTY, OREGON
Surveys in
SECTION 19 T.30 S., R.3 W. W.M.
Aug. 1950 - April 1951.

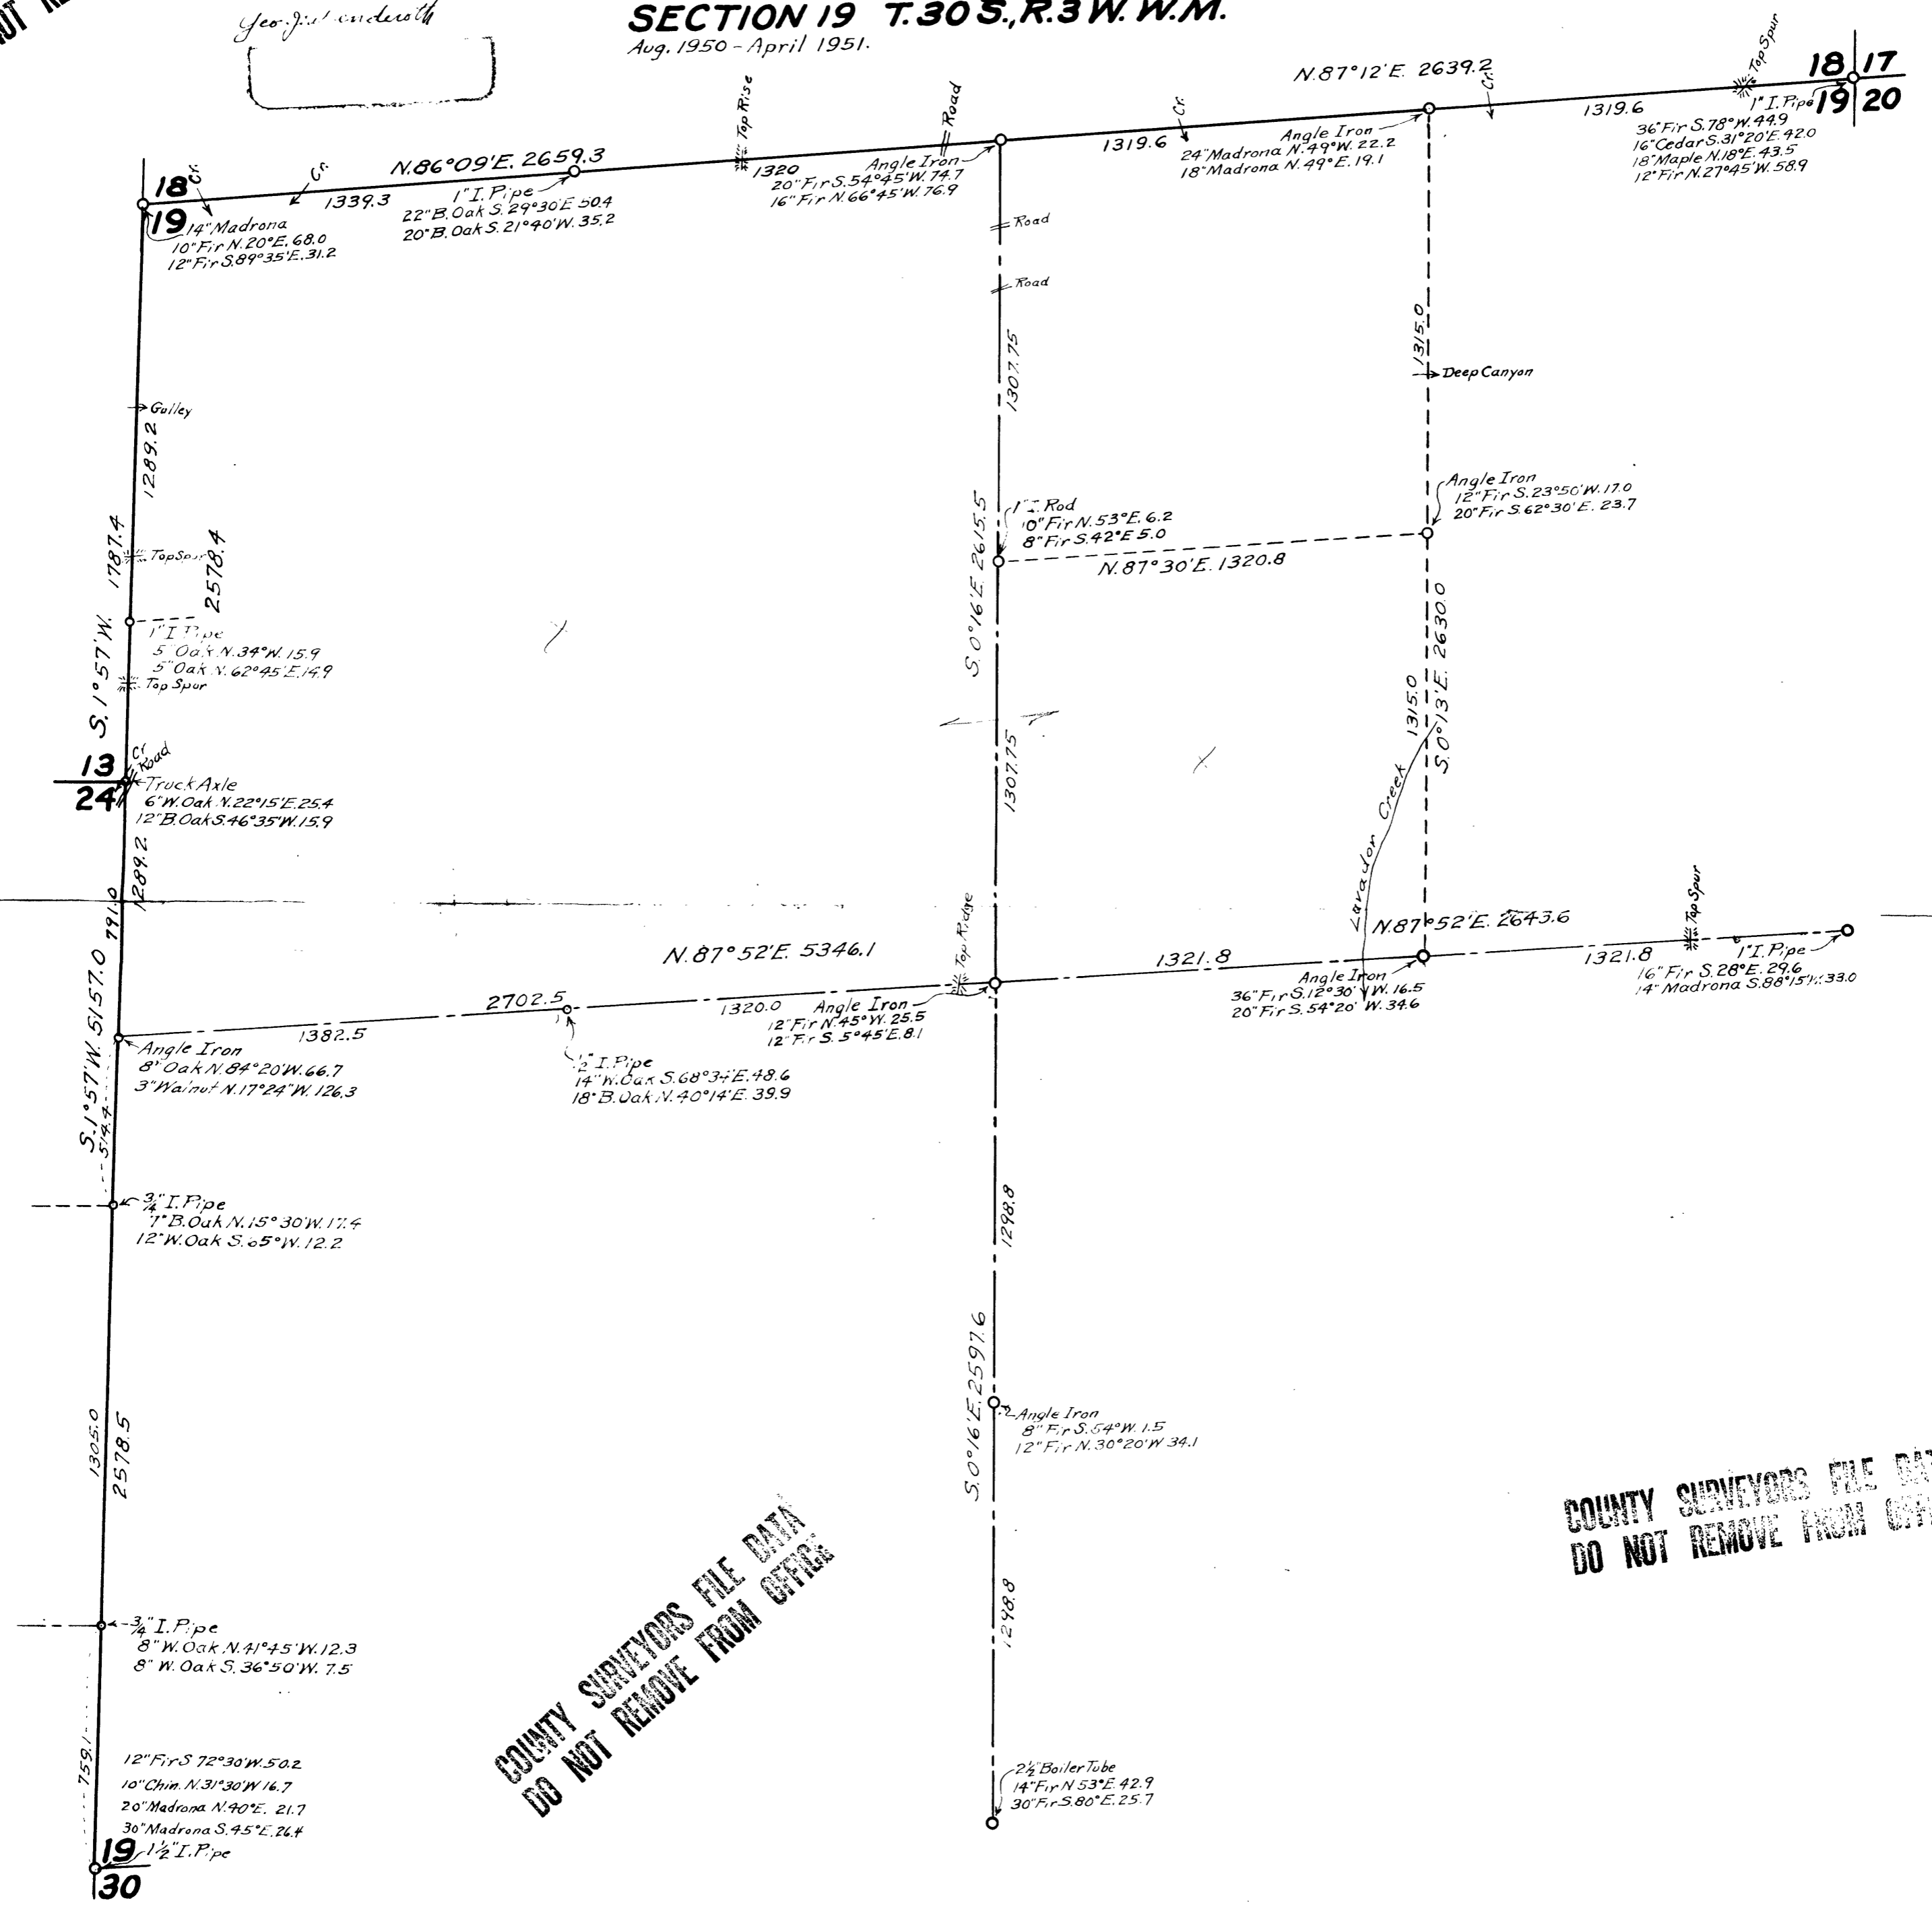

COUNTY SURVEYORS FILE DATA
DO NOT REMOVE FROM OFFICE

COUNTY SURVEYORS FILE DATA
DO NOT REMOVE FROM OFFICE