

T30S, R5 W.

8-31-50

Approx. Corner.

Beginning at the N.E. corner of D.L.C. #43; thence West 1465', I set a 1"x30" I.P. 45" in ground.


From which An Ash 7" diam. bears S68W, 20.0' dist. mkd. P.C. 2880, B.T.

This corner should be the S.W. cor. D.L.C. #45, the corner fits the Field Notes both North + West for river being but the O.B.T. is missing.

The corner lies half-way down a steep bank, just North of gravel pit + 70' East of River.

Witness:

Geo. Vaughn
F.E. Weaver

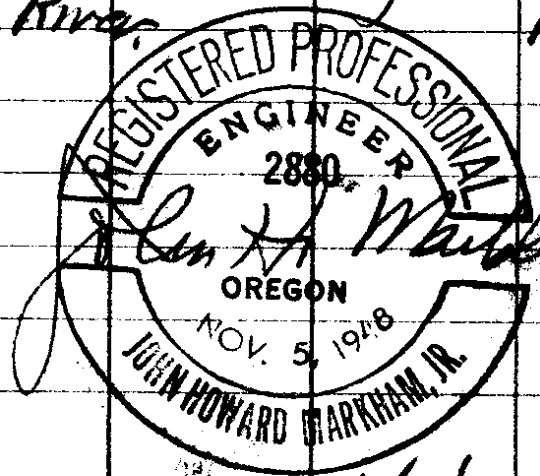

S. File No. 40/273²

40/273 - 2

Work done for F.E. Weaver