

9-9-50

1/4 Section Corner 21-22, T28S,
R4W, W.M. as set by propor-
tional measurement.

At corner point set 1" x 30"
iron pipe 15" in ground
from which

A Maple 7" diam bears S87E


16.0' dist mhd. 1/4 S, 2880, B.T.

A Fir 10" diam bears N42°30'W,
28.5' dist, bark scribed 1/4 S
2880, B.T.

V.C. Dunnavin's barn bears
S72°E approx. 405' dist.

Witness:

Geo Vaughn

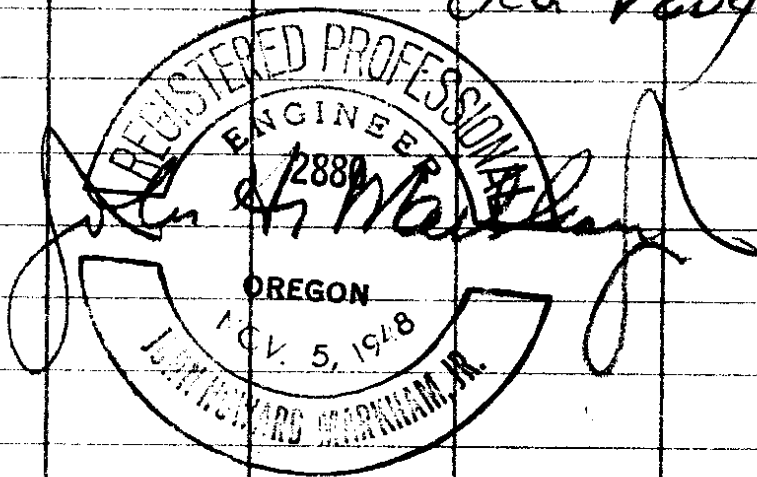

Work done for Steman Lbr. Co.

G.S. File No. 40/277-2