


10-15-50

N.W. Corner D. L. C. #42, T30S, R6W  
set 40.92' North of  $\frac{1}{4}$  Sec.  
Corner 26-27, T30S, R6W  
At corner pt. set 1" I.P.  
from which

A Cottonwood 40" diam. bears  
N73E, 55.3' dist. mkd Cl. 47 2880, B.T.  
An Ash 7" diam. bears N81W,  
123.2' dist. mkd. Cl. 47, 2880, B.T.  
The fence cor bears South  
14" where I fd.  $\frac{1}{2}$ " I.P. The  
fences run West & South.

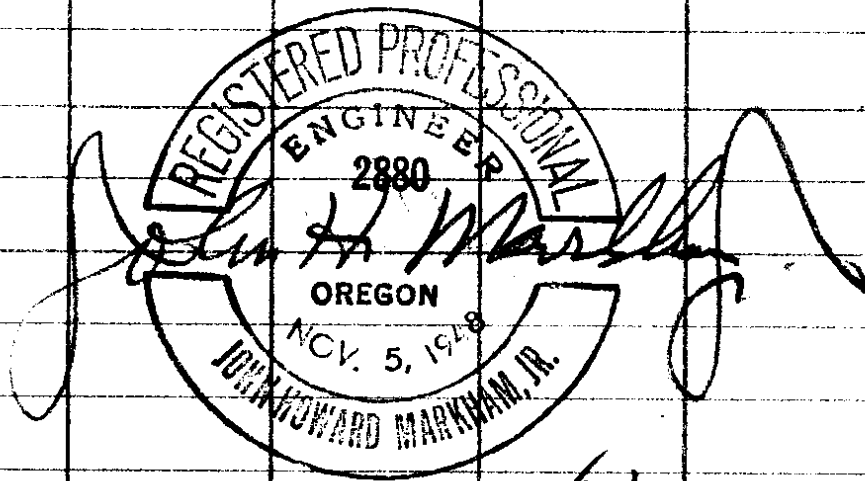

Witness  
Bill Vaughn  
Geo. Vaughn

File No. 40/277.3