

4-8-51

Section Corner 5-6-7-8

T 285, RAW W.N.R. as

determined by an O.B.T.

A La. 20" diam. bears S20E  
23.0' dist scribed S7, T285,  
RAW "O.B.T."

At cor pt set wood post  
from which

A Fir 11" diam. bears S49E,  
26.0' dist, mkd. S8, B.T.

A La. 14" diam. bears S74W,  
38.0' dist, mkd. S7, B.T.

A La. 14" diam. bears N27W,  
47.0' dist, mkd. S6, RAW,  
B.T.

A La. 38" diam. bears  
N30E, 17.0' dist. mkd.  
S5, T285, RAW, 2880, B.T.

Witness:

Geo. Vaughn


Harry Collison

(OVER)

C.S. File No.

90/277<sup>5</sup>

The Scribe on the O.B.T.  
was very plain and faced  
N20W however since  
this tree was scribed S7,  
it belonged in the SW  $\frac{1}{4}$ ,  
no other trees would fit  
the field notes but I feel  
that the 38" lg. I scribed  
was an O.B.T. the gov't  
notes being in error.

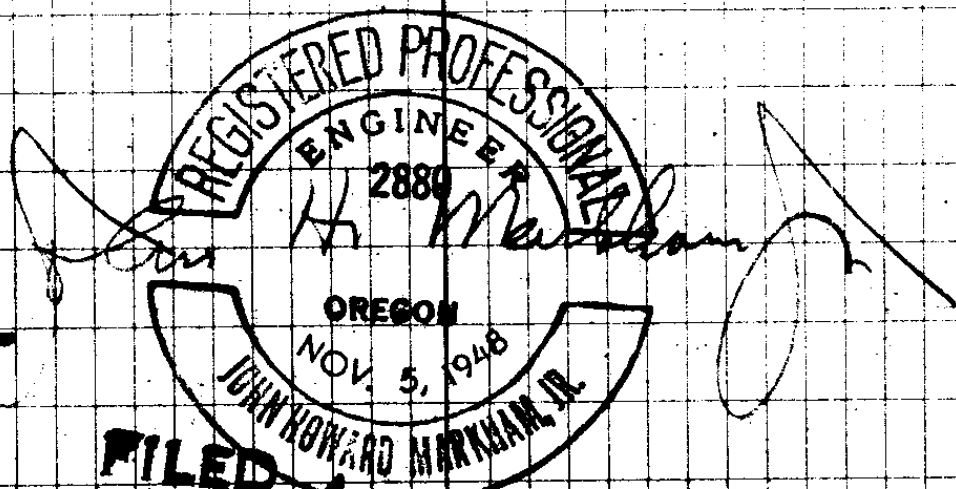

FILED & RECEIVED  
12-51

APR 12 1951

COUNTY SURVEYOR  
GLAS COUNTY, ORE  
Work done by Breedlove