

7-16-51

Section Corner 4-5-8-9,
T30S, R6W, W1N, as set by O.B.T.

A Fir 36" diam. bears N57E,
245.0' dist. O.B.T. fd. scribe.

A Fir 37" diam. bears N7W
57.0' dist. D.B.T.

At corner pt. fd. old
rail fence corner, large
stone + set 1' x 30" 1.P.

from which

A Fir 9" diam. bears N55W, 64.0'
dist. mkd. S5, B.T.

A Fir 50" diam. bears N4E,
44.0' dist. mkd. S4 T30S, R6W B.T.

A Fir 18" diam. bears N23E 78.0'
dist. mkd. S4, B.T.


Old fence bears North +
East from corner

This corner lies in the
North end of an opening
just on the East side of
main ridge.

OVER

G.S. No. 40/277-7

Witness:
Geo Vaughn

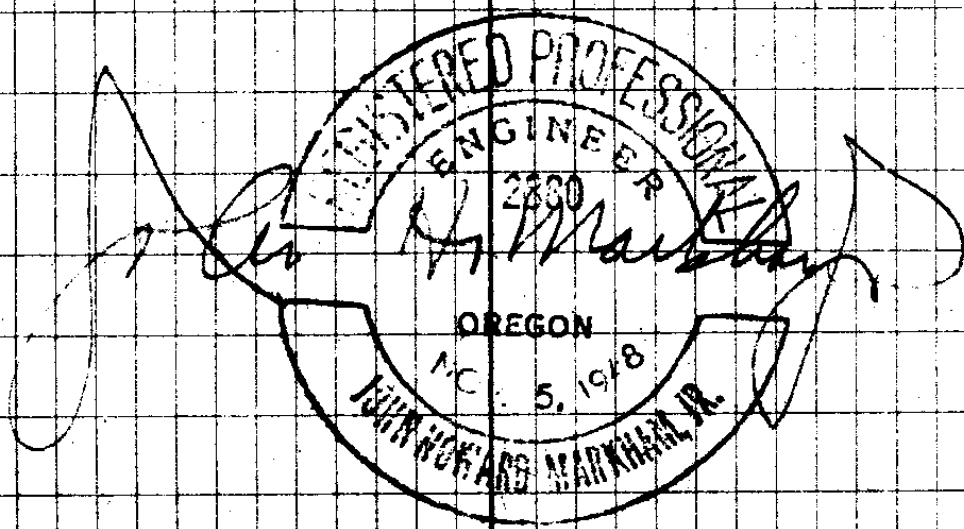

FILED
RECEIVED

JUL 27 1951

COUNTY SURVEYOR
DOUGLAS COUNTY, ORE.

Work done for Stoman Abr. Co.