

12-23-50

Correction on Renewed Corner

- West $\frac{1}{4}$ Section Corner
Sec. 30, T30S, R4W, W.M.

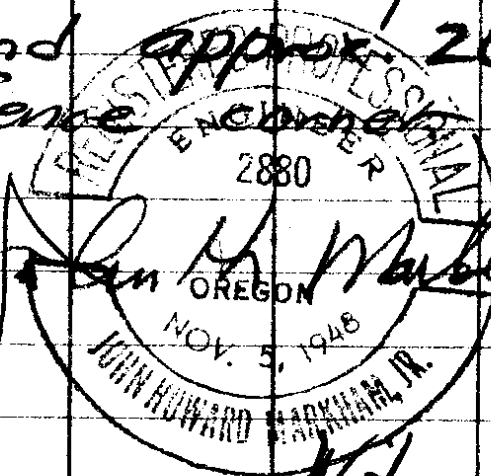
- A W.O. 40" in diam. bears
South 30° West, 264.0' dist.
from truck axle & post scribed.

- This W.O. has old scribe
visible and has been remarked
1581, B.T. and is O.B.T.

Corner pt belongs

South $00^{\circ}30'$ West, 264.0'
dist. as called for in field
noted.

- True cor. pt. would lie very
close to present N & S fence
and approx. 260' North of
fence

John H. Marshall

 JOHN HOWARD MARSHALL, JR.
 OREGON
 NOV. 5, 1948
 2880

C. S. File No. 40/296²

Witness: Geo. & Bill Vaughn.

Work done for Storman Lbr Co.