

4-7-51.

North $\frac{1}{4}$ section corner,
Section 5, T30S, R4W, W1M.

This corner was never set
by the Govt. At midpoint
on Turp. Line I set a
1 x 24" I.P.


from which

A Fir 12" diam. bears S21E,
109.0' dist. mhd. $\frac{1}{4}$ S, SS, B.T.

A La. 20" diam. bears S52W,
73.0' dist. mhd. $\frac{1}{4}$ S5,
T30S, R4W, 2880, B.T.

The cor. lie on the North
edge of a small clearing.

SE, cor. Sec. 32 bears
East

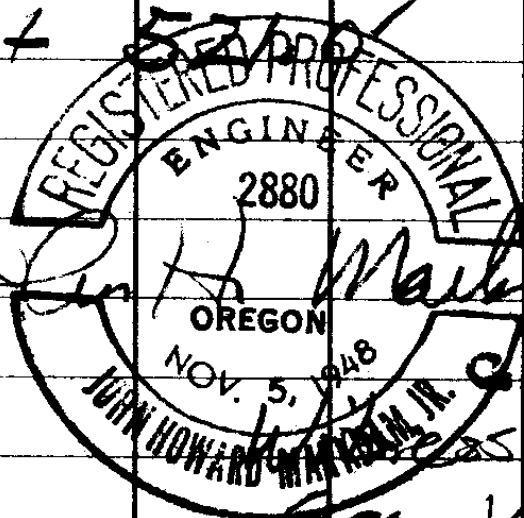

John H. Marshall, Jr.
C.E. File No. 40/296

Geo. Vaughn
Don Weathers

Work done for McFarland + Long