



# General Location

T30-4

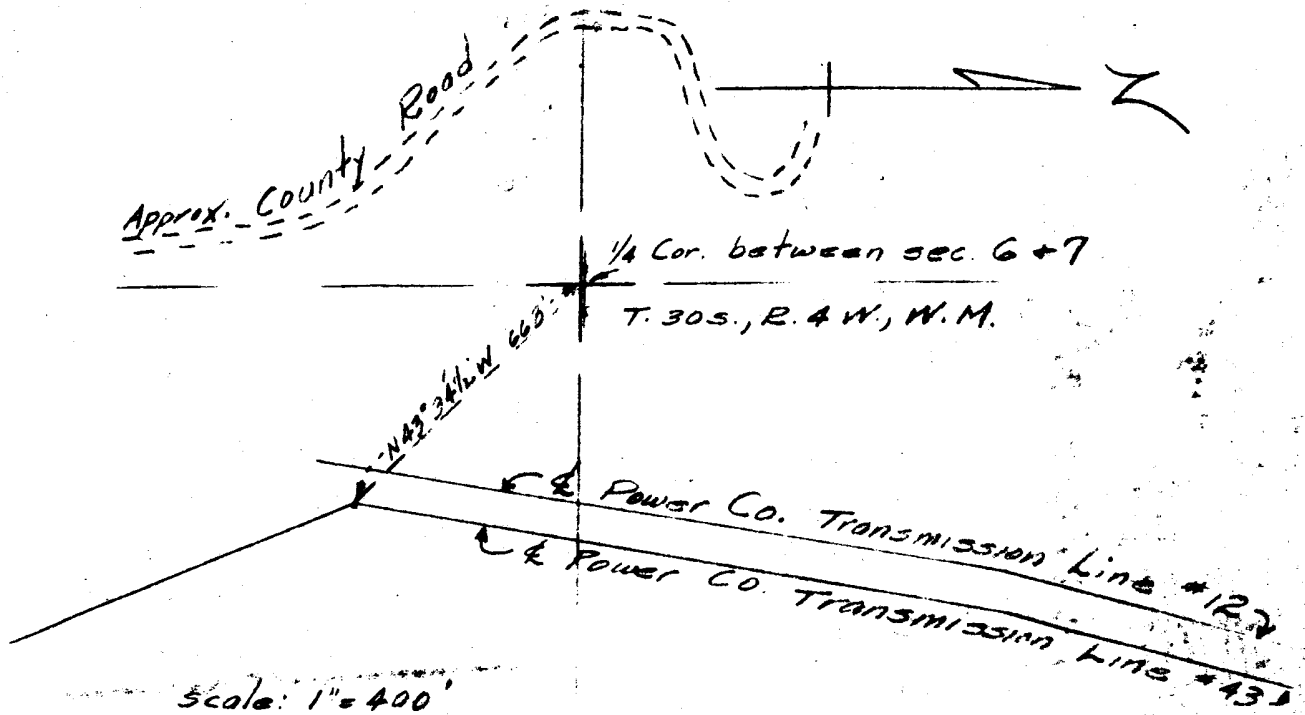

# Corner Details

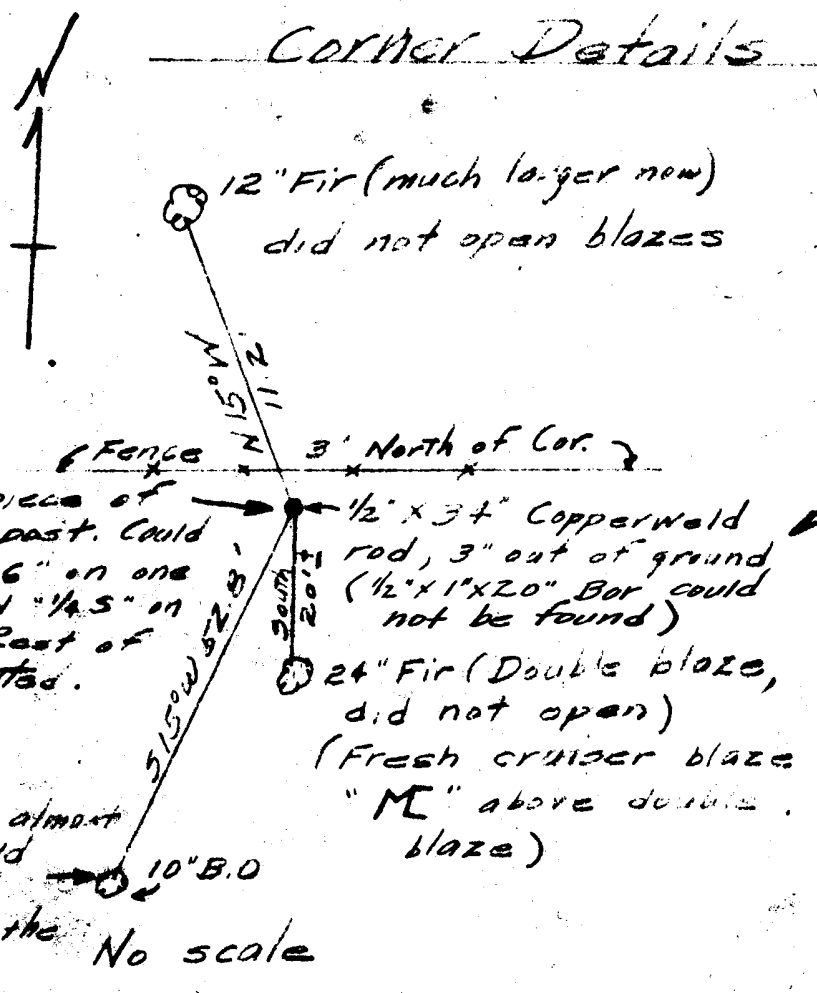

OREGON  
LAND SURVEYOR

NOVEMBER 10 1950  
THOMAS R. ESLINGER  
268

Feb. 2, 1951

CS 10/299-1