



General Location T28-5

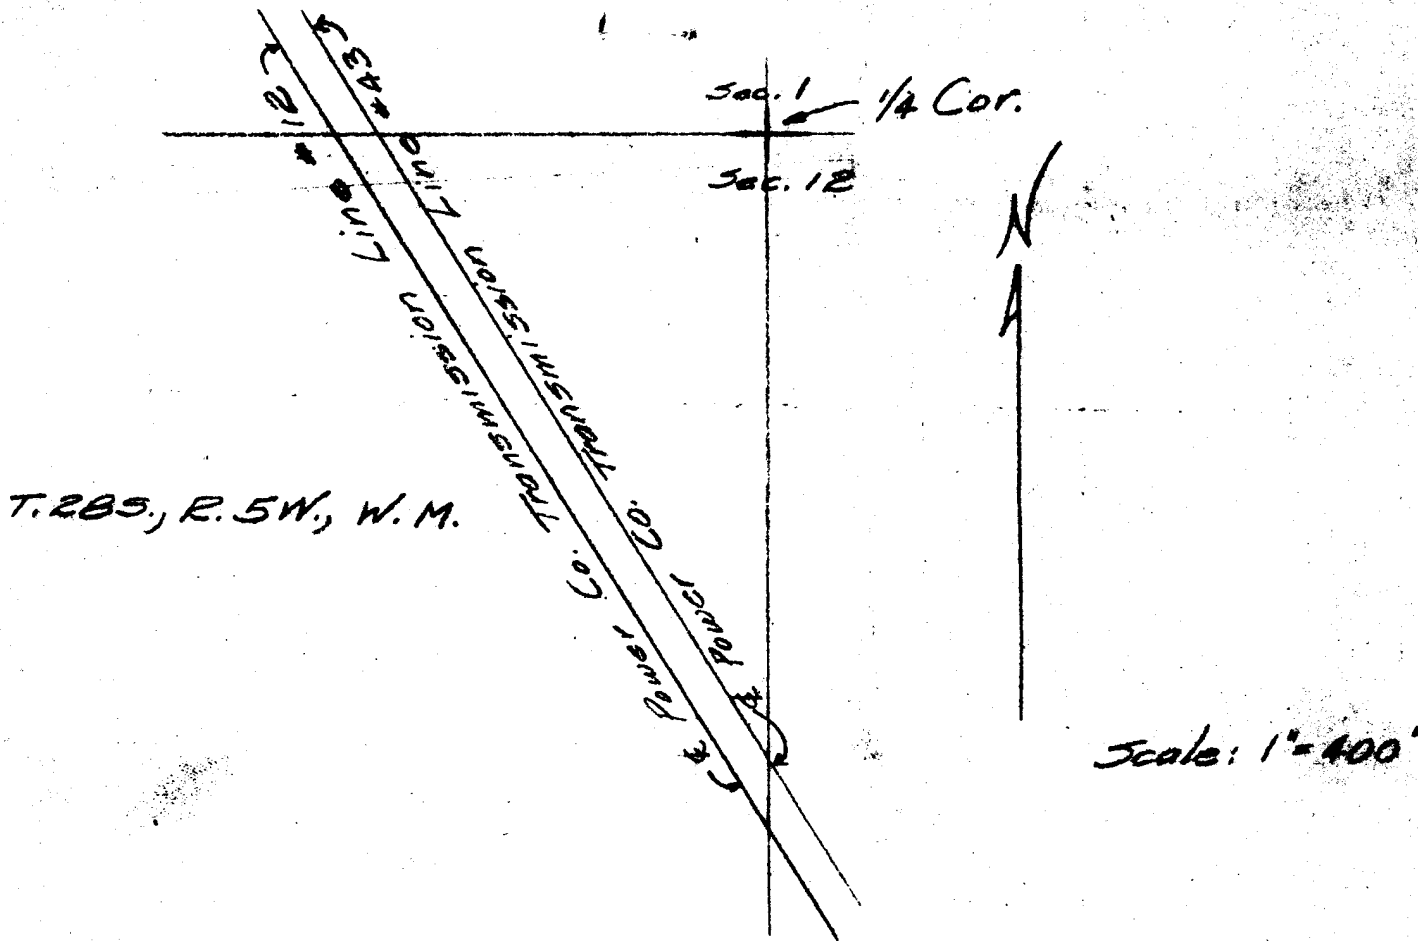

Corner Details

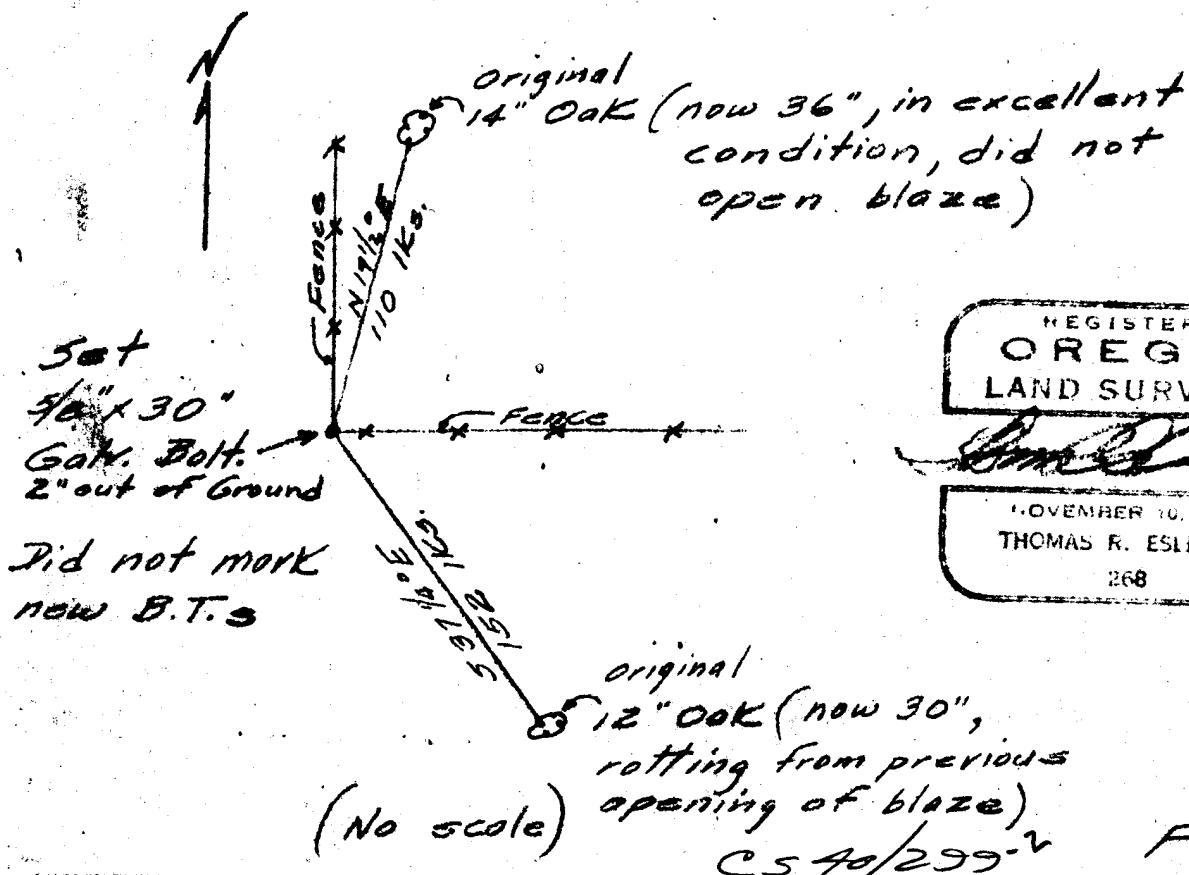

REGISTERED
OREGON
LAND SURVEYOR

Thomas R. Eslinger

NOVEMBER 10, 1950
THOMAS R. ESLINGER
268

Feb. 27, 1951