

3-31-51

Closing Corner Section

4+5 on Twp. Line,

T23S, R7W, W.M. as

determined by O.B.T.

A B.O. Stamp hole bears

S13°E, 94.0' dist.

At cor. pt. set 1x24" I.P.

from which


A B.O. 7" diam. bears S46W,

23.0' dist. mkd. S5, B.T.

A La. 9" diam. bears N87E,

63.5' dist. mkd. S4, B.T.

There is a fence running
S-E-W from this cor.

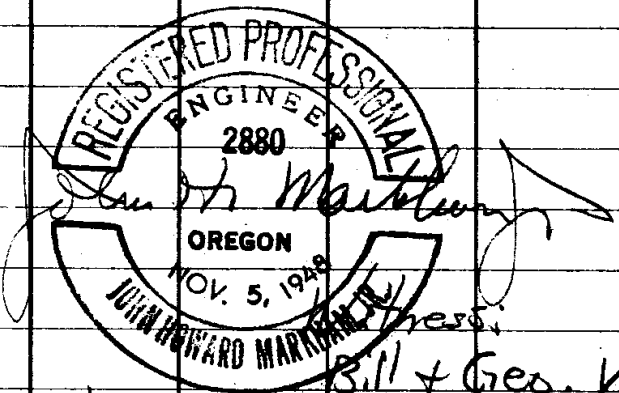

Bill + Geo. Vaughn

S. File No. 40/303-1

Bob Blair

Work done for Monore Lbr Co.
Eugene.