

3-31-51

Closing corner Section

3+4 on Twp. Line,
T23S, R7W, W.1/4 as
determined by O.B.T.

A Fir 36" diam. bears S28W,
18.0' dist.; I chopped out
this B.T. and for scribe.


At cor. pt. set 1x24"
I.P.

From which

A 1.24" diam. bears S47W,
63.0' dist. mkd. S4, B.T.

A Fir 20" diam. bears
S76E, 55.0' dist. mkd.
S3, 2880, B.T.

Fence cor. bears S10°E,
approx. 100'. Fence runs
West + North from fence cor.

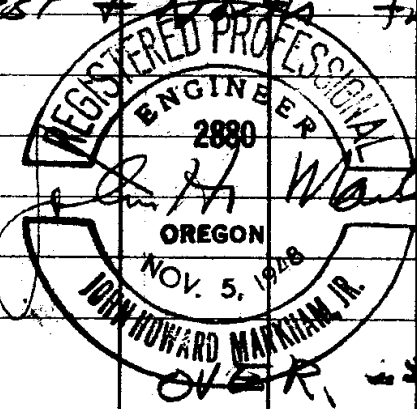

File No. 40/303

The field notes along
Twp. line check very
close.

The distance from
Cor. to Cor. along North
line of Section 4
is 5210.0'. The
East half of the line
being extremely steep
with some bluffs.

FILED 4-5-51

RECEIVED

Witness:

Bill + Geo. Vaughn

APR 5 1951 Blain

COUNTY SURVEYOR
DOUGLASS COUNTY, ORE

Work done for Monroe
Lbr. Co. of Eugene.