


N.E. Cor. Sec. 16.

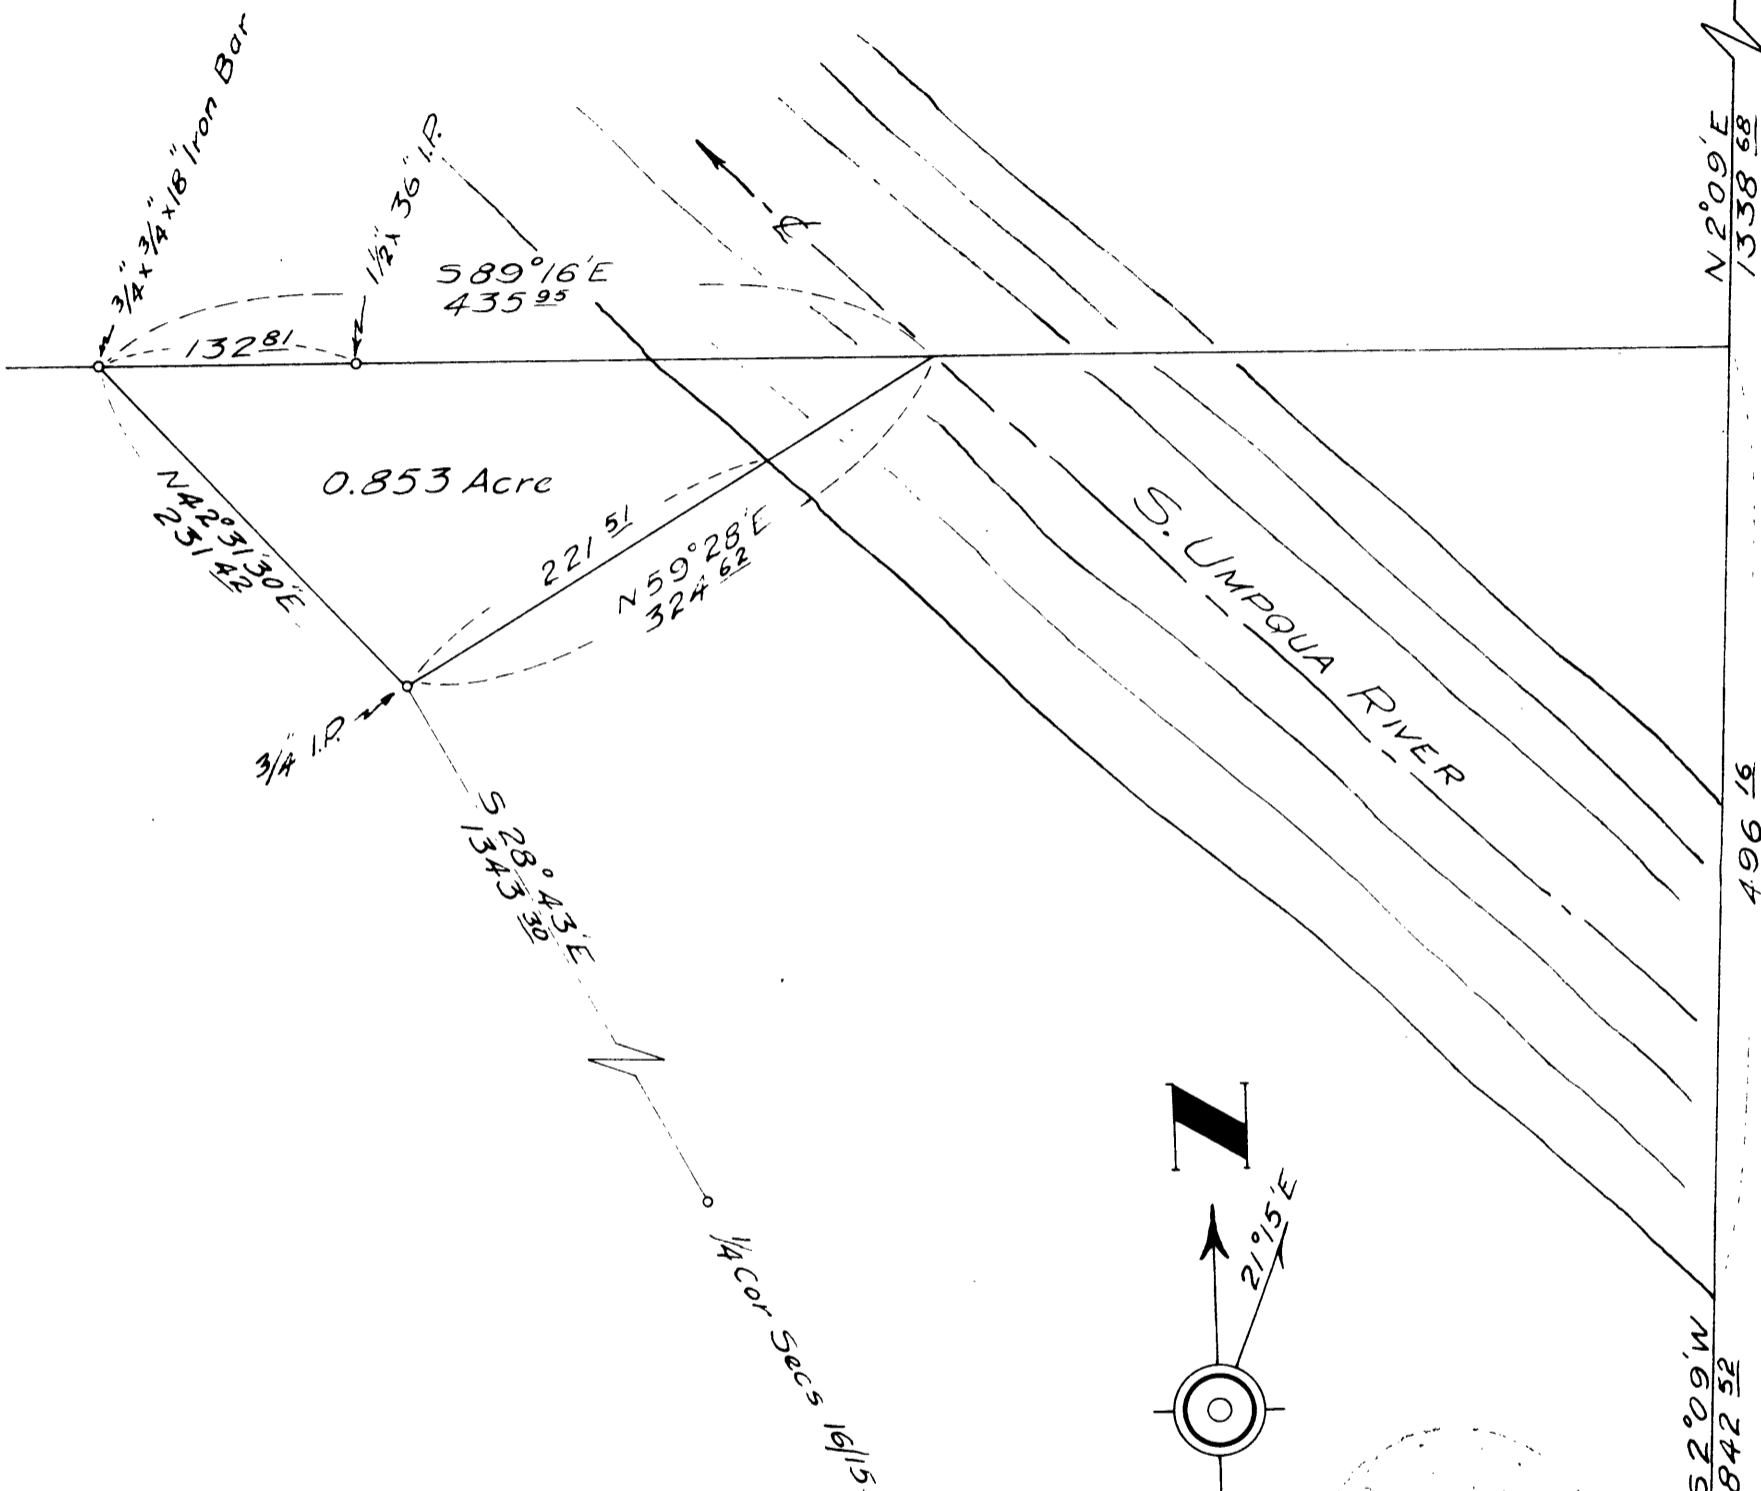

PLAT OF
 SURVEY FOR PAUL HELWIG
 SEC. 16, TWP. 28 S, RNG. 6 W., W.M.
 Made - August 1946.
 Scale - 1-inch = 100 ft.

ORIG. FILED AS CS 41/138