


MAP  
of  
LANDS SURVEYED  
for  
CLAY ULAM  
SECTION-18-TP.29S-RG.5W.WM.  
Scale-1"=100. April-1950.

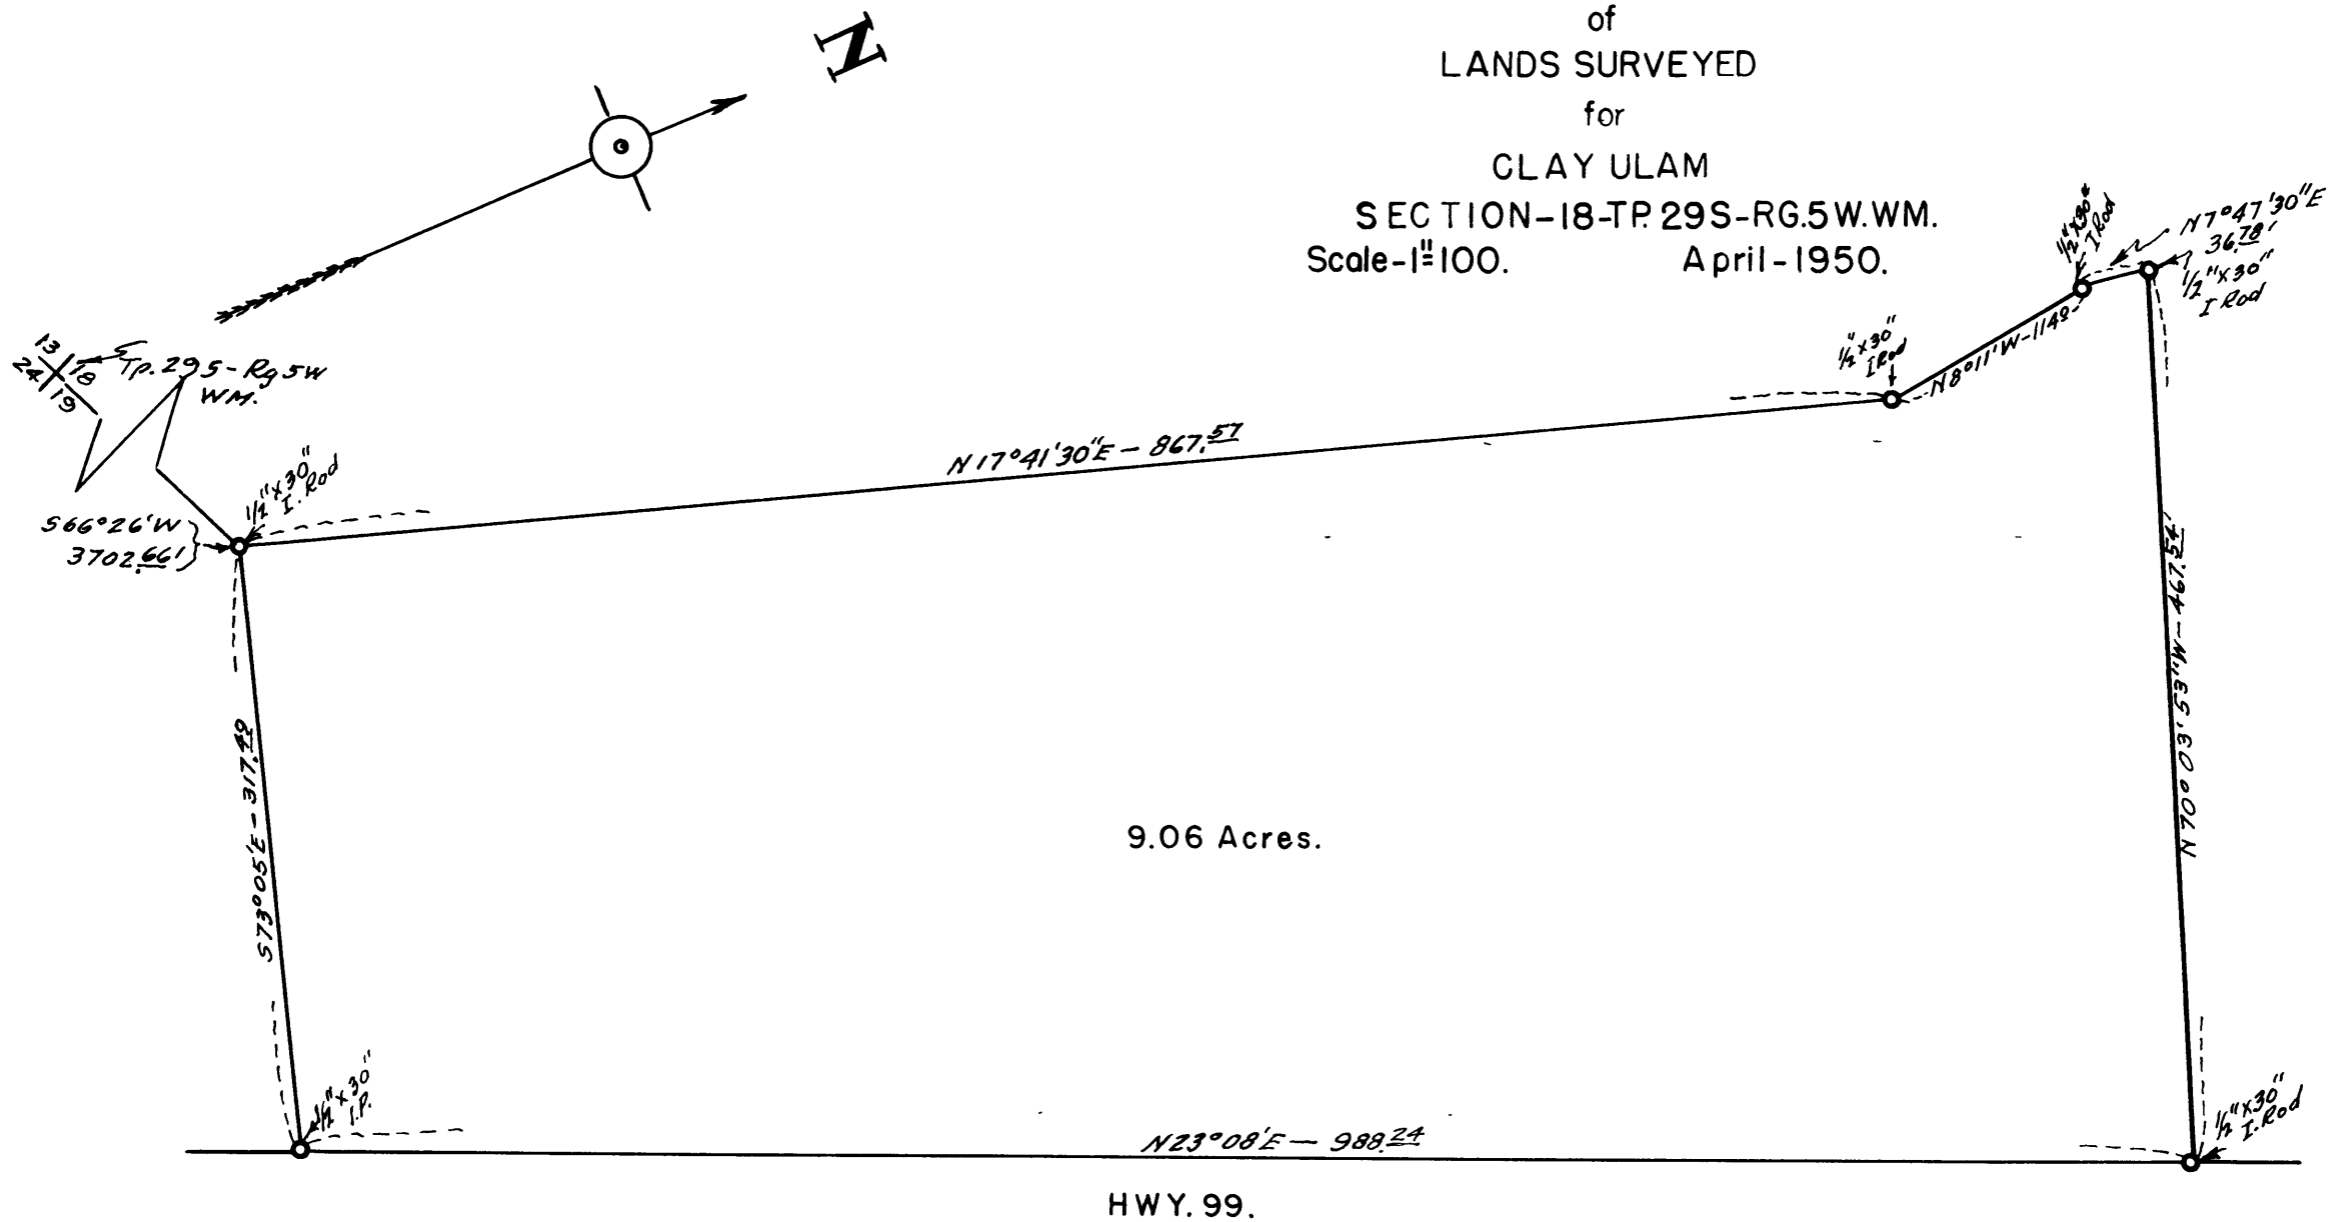

9.06 Acres.

HWY. 99.

COUNTY SURVEYORS FILE DATA  
DO NOT REMOVE FROM OFFICE

FILED  
RECEIVED  
JUN 1950  
COUNTY SURVEYOR

