


46-55

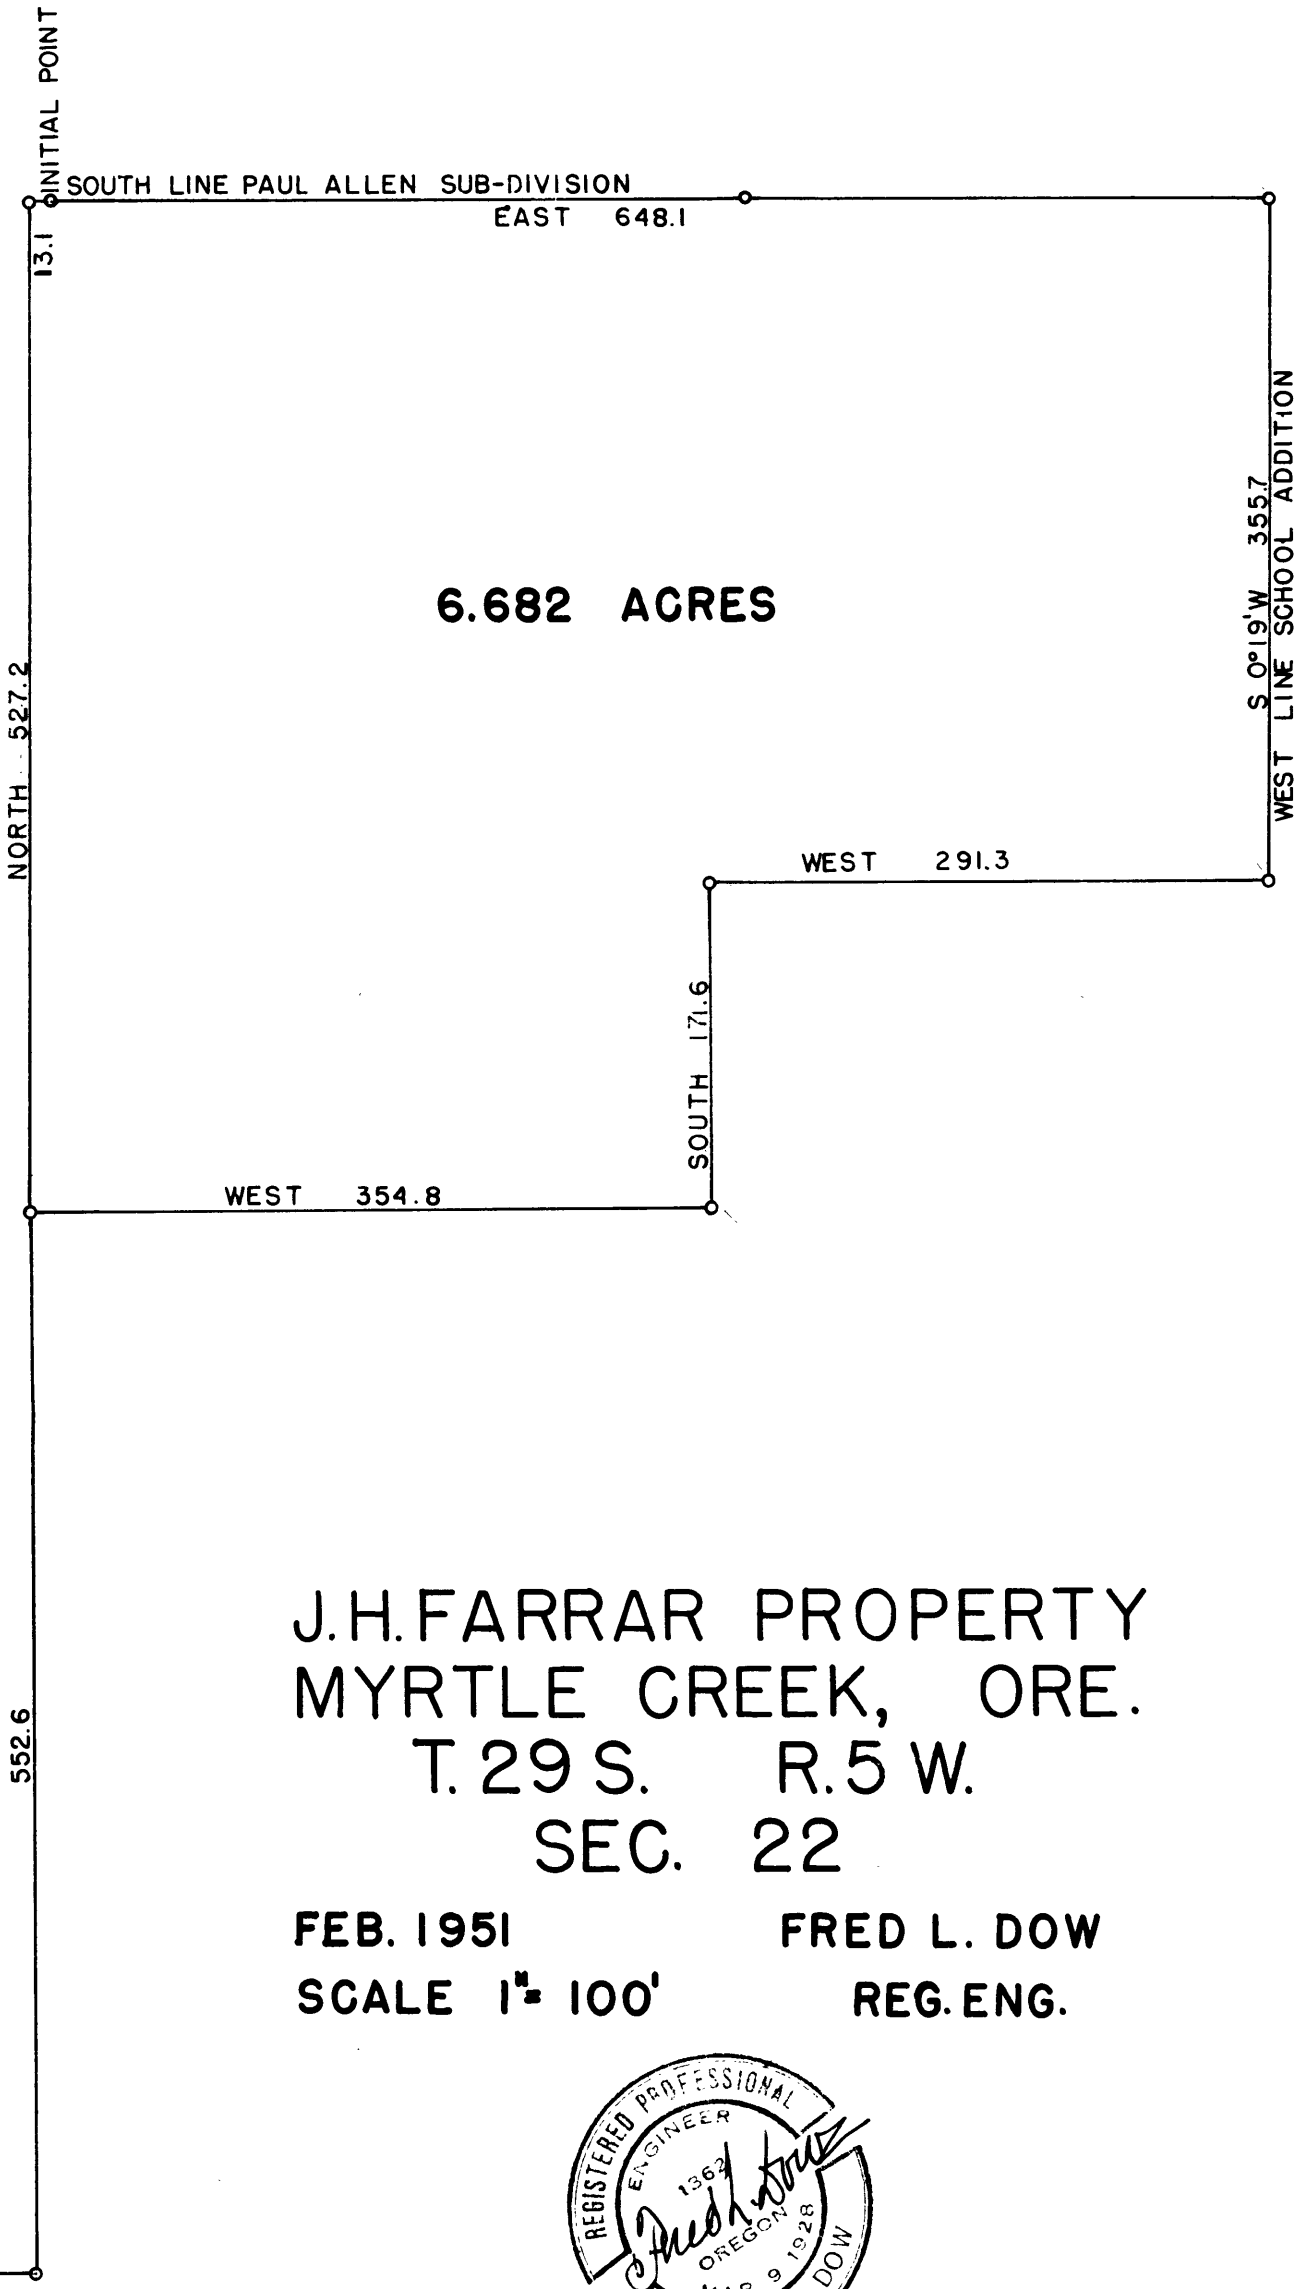

J.H.FARRAR PROPERTY
MYRTLE CREEK, ORE.
T.29 S. R.5 W.
SEC. 22

FEB. 1951
SCALE 1" = 100'

FRED L. DOW
REG. ENG.



21 22
28 27

1334.4

T.29 S. R.5 W.

COUNTY SURVEYORS FILE DATA
DO NOT REMOVE FROM OFFICE

CS FILE FOLDER

CONTAINS

MORE

INFORMATION