

8-8-51

N.E. Cor. Section 5, T31S,
R3W, W.M. as det. by O.B.T.

A Fir 15" diam bears N11W
24.4' dist, I chopped out &
fd. scribe.

A 36" Fir wind fall bears.


S12E, 50.0' dist. O.B.T.

At corner pt. fd. large
stone & drove 1" x 30" I.R.
from which

A La. 8" diam. bears S23W,
12.0' dist. mtd. S5, T31S,
R3W, B.T.

Witness:

Geo Vaughn

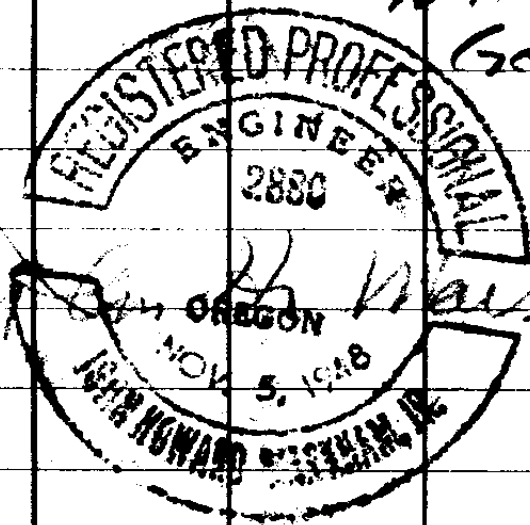

Work done for Joe Ritter -2

S. E. No. 40/363 F 40-363