


8-14-51

1/4 Sec. Cor 13 and 24  
T29S, R6W, W1N, as set  
by proportional measurement.

At midpoint on Section Line  
I set 12" 30" I.P.

From which  
A Fir 40" diam. bears N15° E,  
6.5' dist. mkd. 1/4 S, B.T.  
A Cedar 36" diam. bears S9° E,  
28.5' dist. mkd. 1/4 S B.T.

Witness:  
Geo. Vaughn

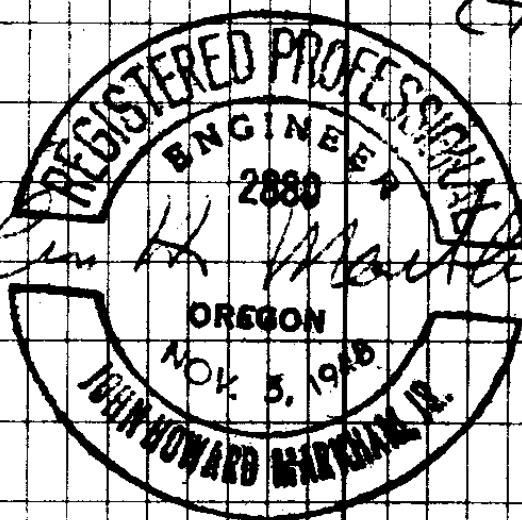

Work done for Stroman Lbr Co.

U.S. File No. 40/363-5