


OLD PACIFIC HIGHWAY (COUNTY ROAD NO. 16)

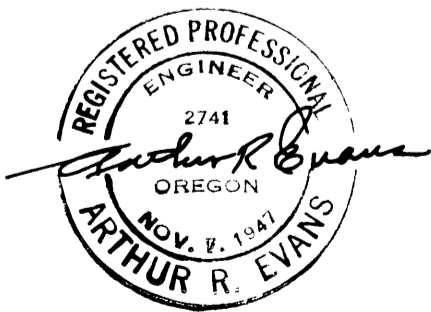

GRANT & EVANS, ENGINEERS
 ROSEBURG, OREGON
 SURVEY TO ESTABLISH LOT CORNERS
 LOT 9 & W'L'Y 18.7 FT. LOT 10, BLK. 2
 "SOUTHVIEW"
 A SUBDIVISION OF LOTS 2 & 3
 "PACIFIC HIGHWAY FRUIT LANDS
 SECTION 2, T28S, R6W, W.M.

SURVEYED & PLATTED, AUG, 1951
 BY A.R. EVANS, REG. PROF. ENGR.
 SCALE 1" = 40'

COUNTY SURVEYORS FILE DATA
 DO NOT REMOVE FROM OFFICE