


PROPERTY SURVEY for  
 HOMER and MINA RADFORD in the  
 A.J. TILLER DONATION LAND  
 CLAIM NO. 63. T.30S., R.5W.



Scale: 1 in. = 200 ft.  
 Date: Sept. 12, 1951  
 Surveyed and Sketched  
 by

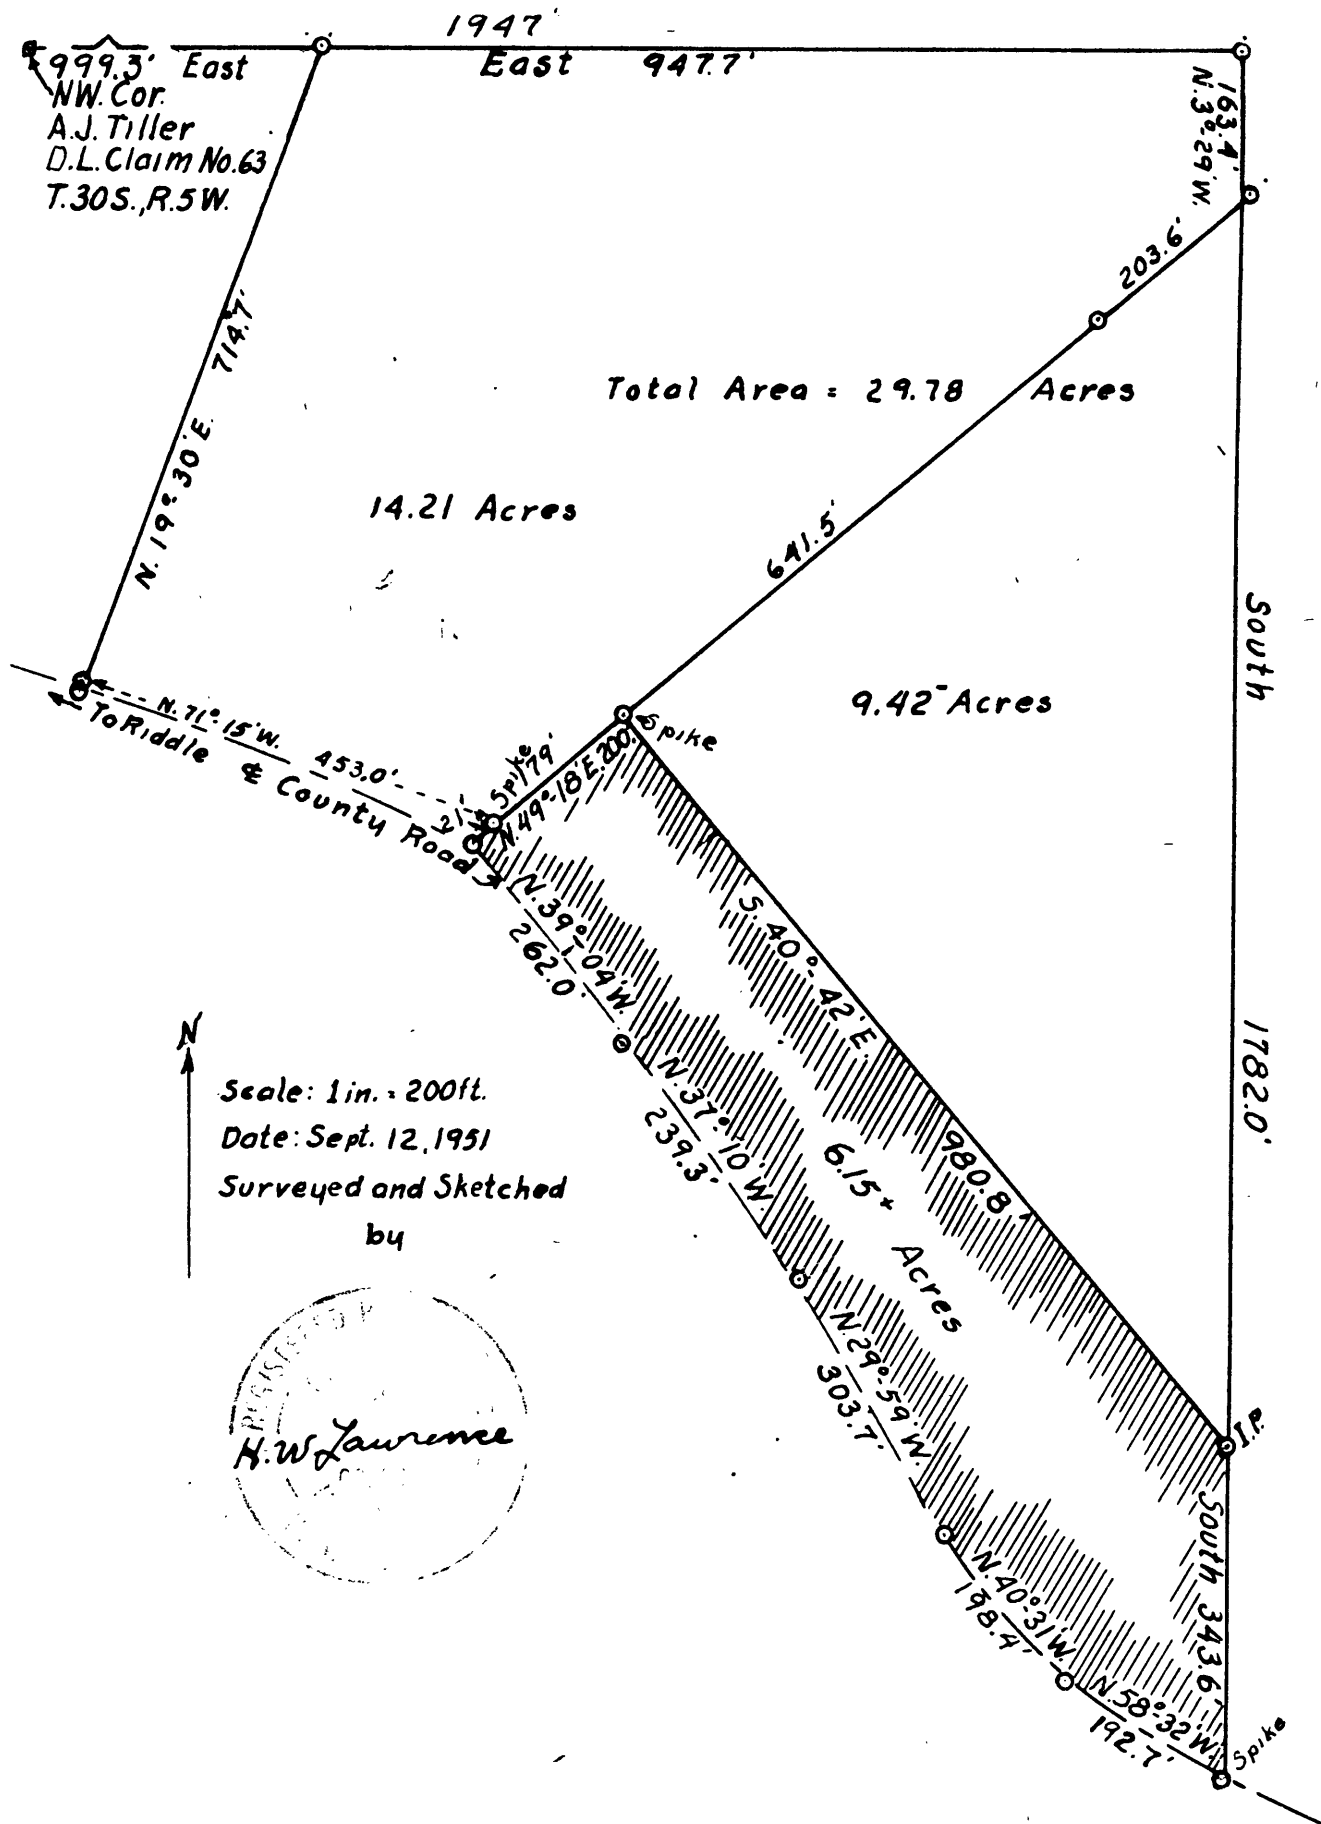