


PROPERTY SURVEY for  
 HOMER and MINA RADFORD-in the  
 A.J. TILLER DONATION LAND  
 CLAIM NO 63. T.30S., R.5W.  
 REVISED

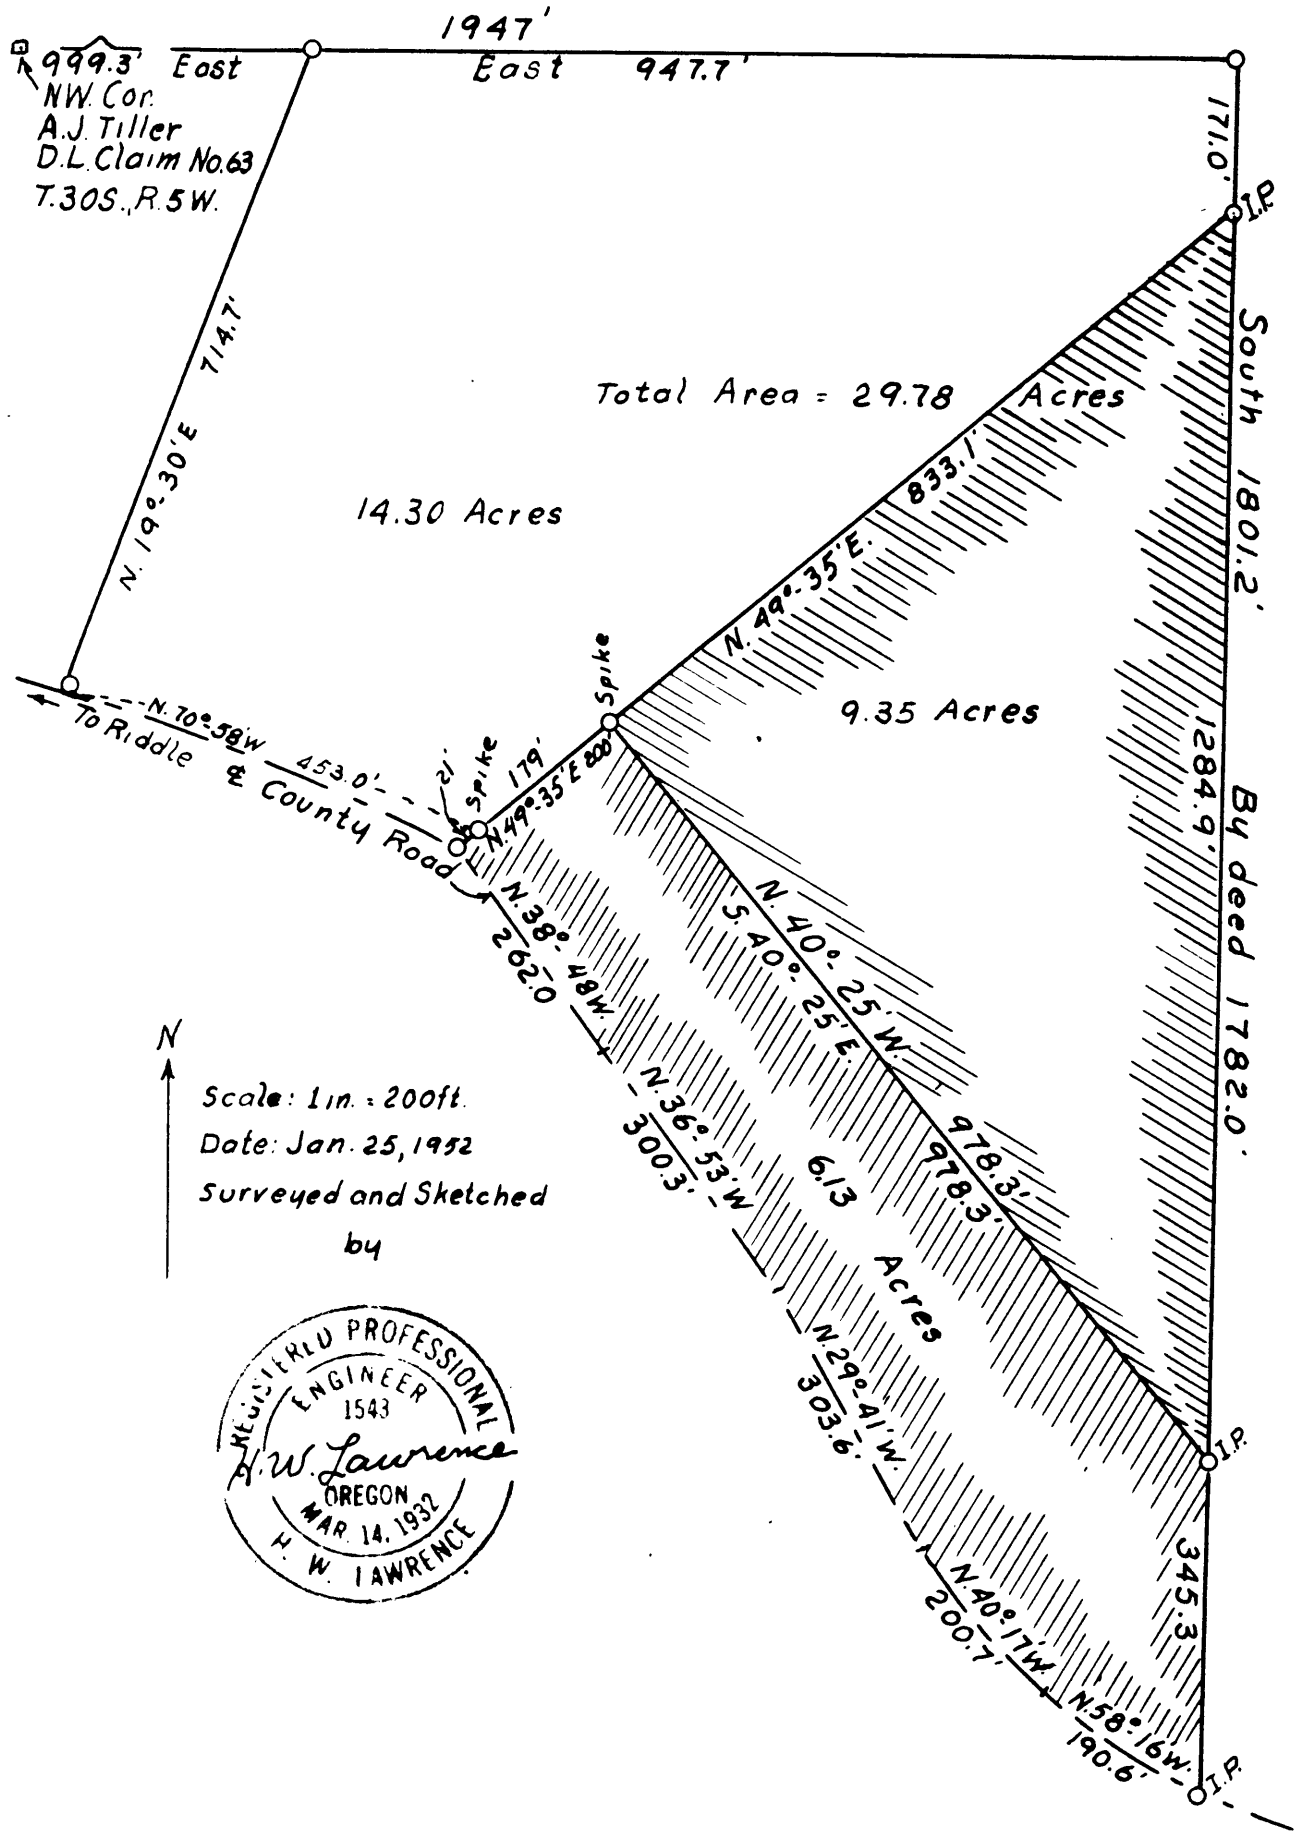

N  
 ↑  
 Scale: 1 in. = 200 ft.  
 Date: Jan. 25, 1952  
 Surveyed and Sketched  
 by

