

1-26-82

1/4 cor 20-21, T30S, R3W,
W.M. as det, by O.B.T.

A Fir 14" diam. bears S16W, 15.0'
dist O.B.T.


A Fir windfall bear N80E,
8.0' dist. O.B.T.

At cor. pt. set 1x30" I.P.
from which

A Fir 30' diam. bears N61E,
20.0' dist. mtd. 1/4S, B.T.

A La. 8" diam. bears S67W,
55.0' dist. mtd. 1/4S, S20, T30S,
R3W, B.T.

COUNTY SURVEYOR
BOULDER COUNTY, ORE

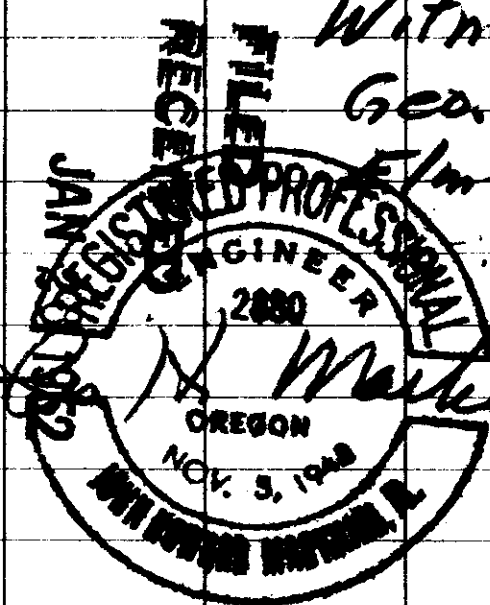

Witness:
Geo + Dennis Vaughn
Elmer Sutton

Work done for Elmer Sutton.

F 40 of 384.2