

✓

11-2-51

S.W. Cor. of Section 35, T29S
R4W, W.M. as determined by
O.B.T.

A B.O. 14" diam bears $54^{\circ}W$,
18.5' dist. O.B.T.

A B.O. stump bears $557^{\circ}E$, 25.0' O.B.T.

A B.O. 14" diam bears $N86^{\circ}E$, 36.0' O.B.T.

A Corner point set $1 \times 30''$ I.P.


from which

A La. 8" diam bears $N42^{\circ}W$,
12.0' dist. mkd. S34, 2880, B.T.

A Pine 8" diam bears $N41^{\circ}E$,
25.0' dist. mkd. S35, B.T.

Witness:

Dennis + Geo. Vaughn

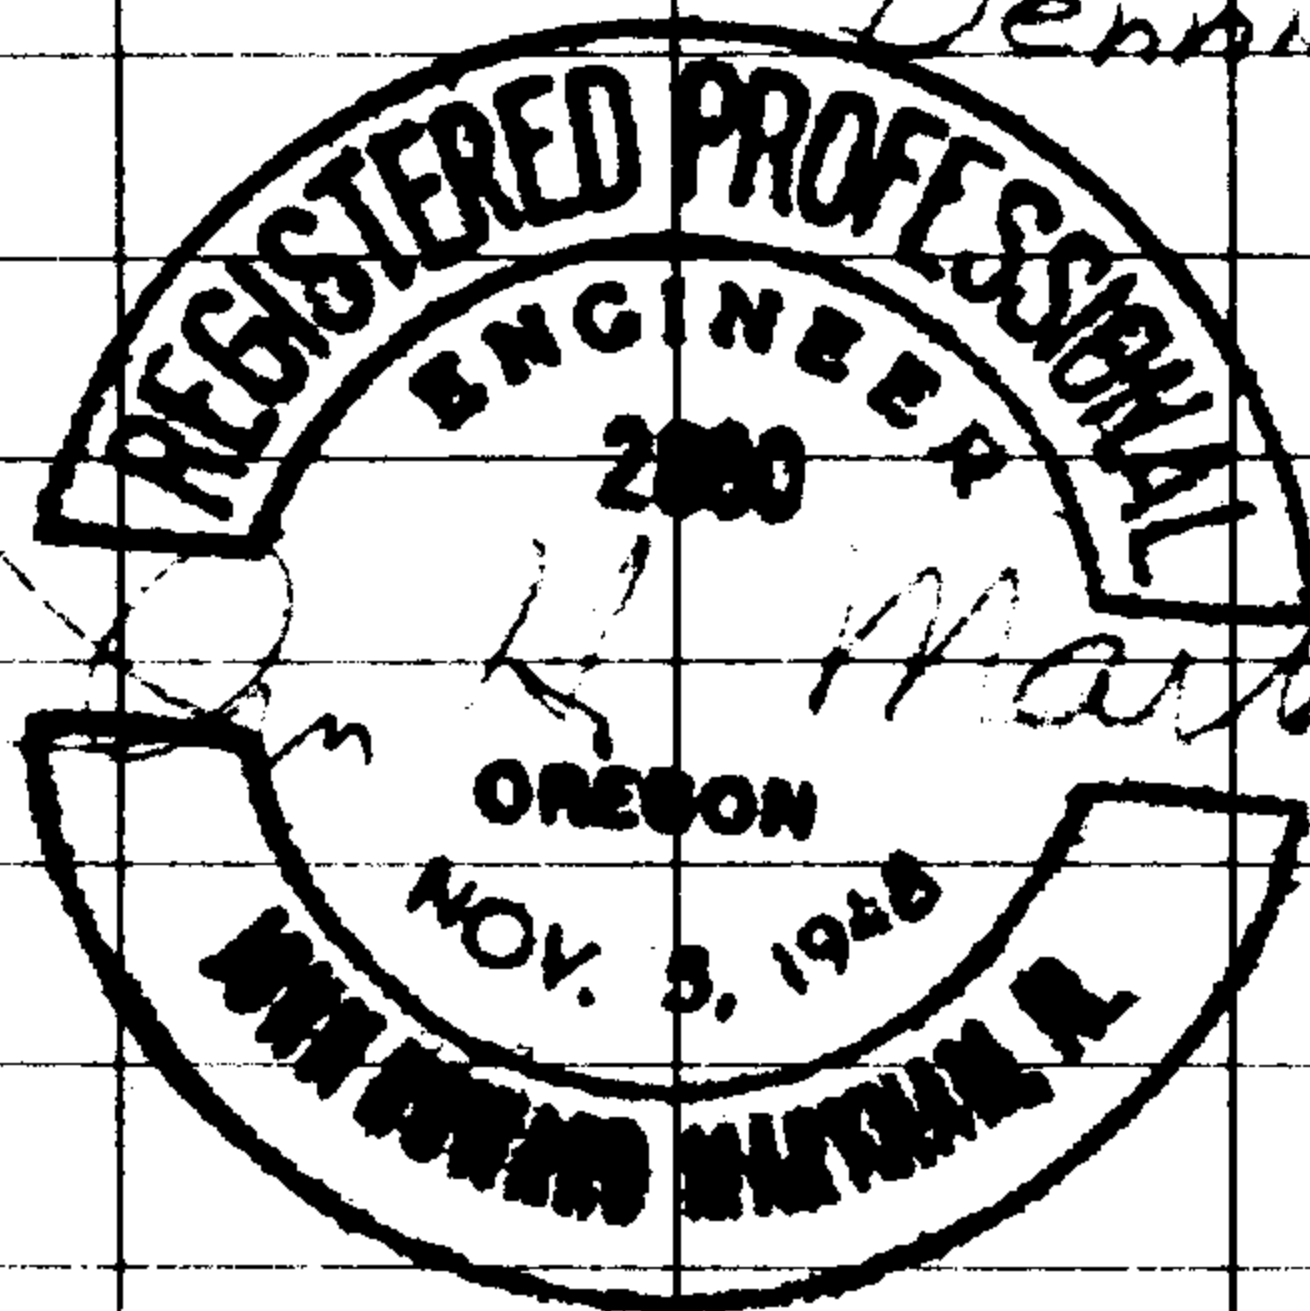

Work done for Stoman Lbr. Co

C.S. File No. 40/386-3