

11-2-51

N.W. Corner of Section 3, T30S,
R4W W.M.

I could read scribe on
both O.B.T.s & rescribed them.

At corner point set 1x30 I.P.
from which

A Fir 9" diam. bears S46E,
27.5' dist. mkd. 53, B.T.

A Cedar 15" diam. bears
S6E, 31.0' dist. mkd. 53, B.T.


O.B.T.s are as follows:

A La. 17" diam. bears S65E, 22.0'

A Fir 48" diam. bears S8W, 16.0'

Witness:

Dennis + George Vaughn

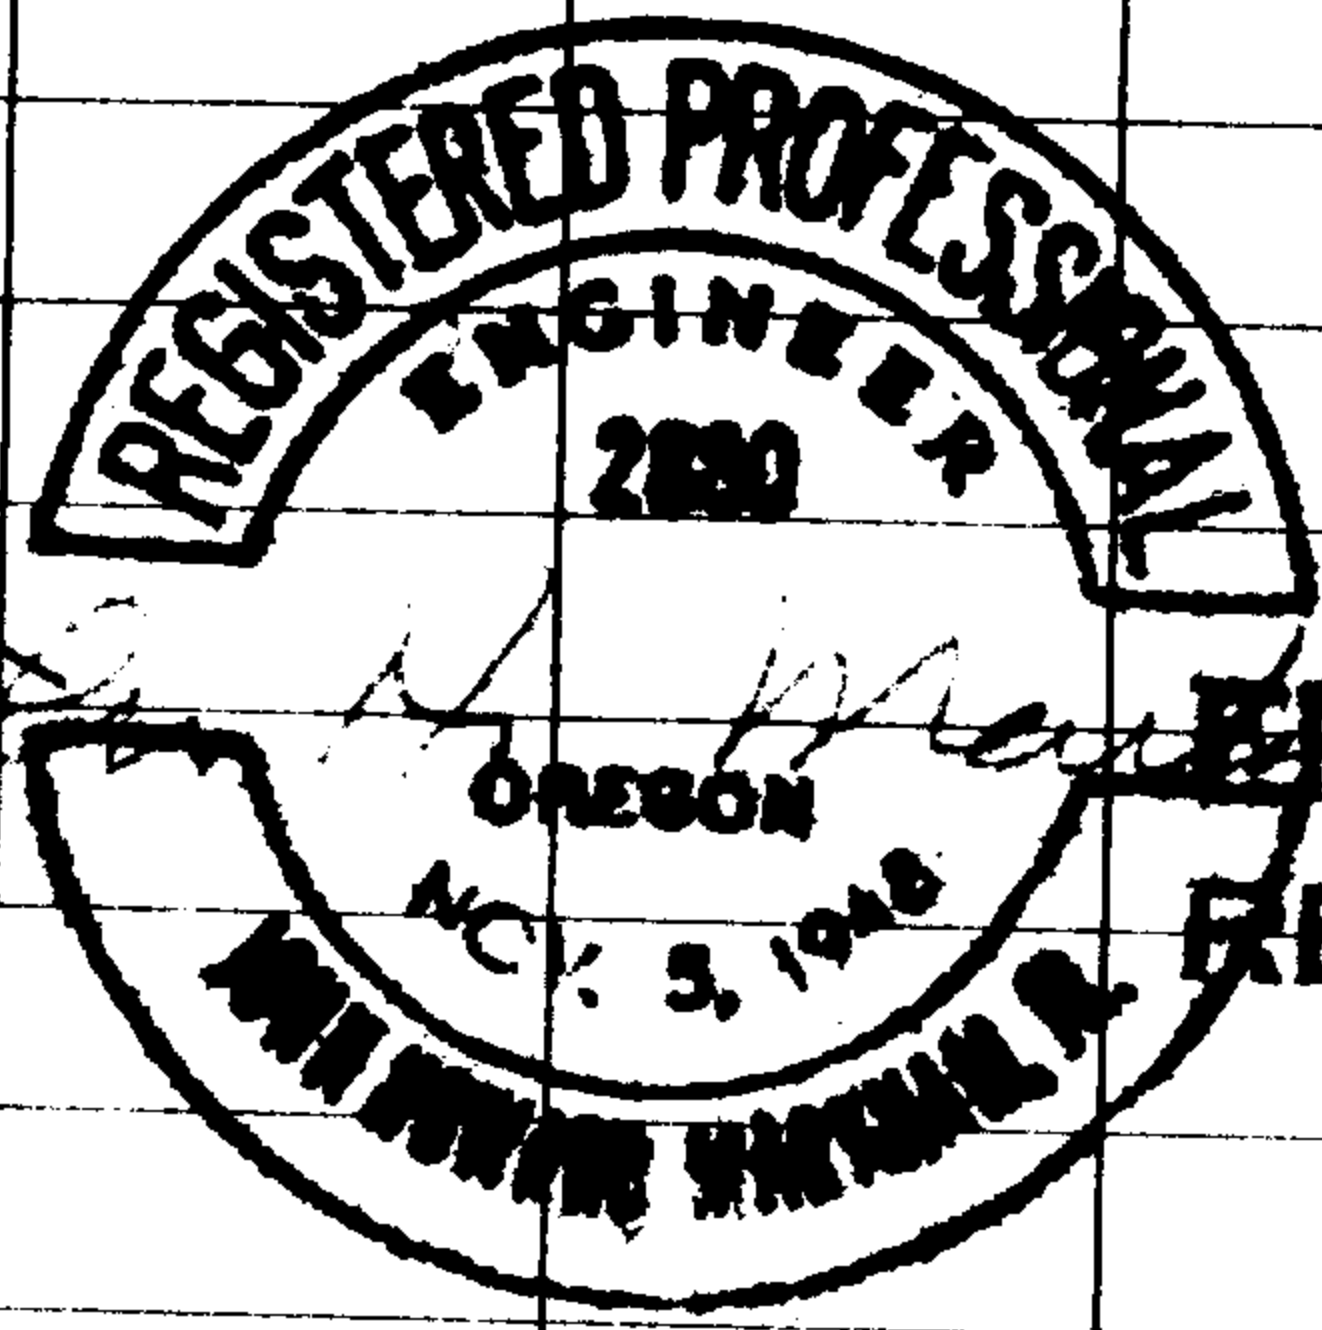

FILED
RECEIVED

NOV 5 1951

Work done for

COUNTY SURVEYOR
DOUGLAS COUNTY, ORE.

C.S. File No. 40/386-4