

3-8-52

1/4 Section Corner 3-4
T30S, R6W, W1N, as determined
by O.B.T.S.

A Fir 24" diam. bears ~~SW~~
S66E, 8.0' - fd. scribe & remarked

A 1A. 24" diam. bears South 13.7'
dist. O.B.T.S. - I remarked,

At corner point set 1" x 30" I.P.
from which


A Fir 10" diam. bears N43W,
24.0' dist. mtd. 1/4 54, B.T.

Creek bears North 35.0'

Twp. Line bears North 2395.0'

Witness:

Geo. & Dennis Vaughn

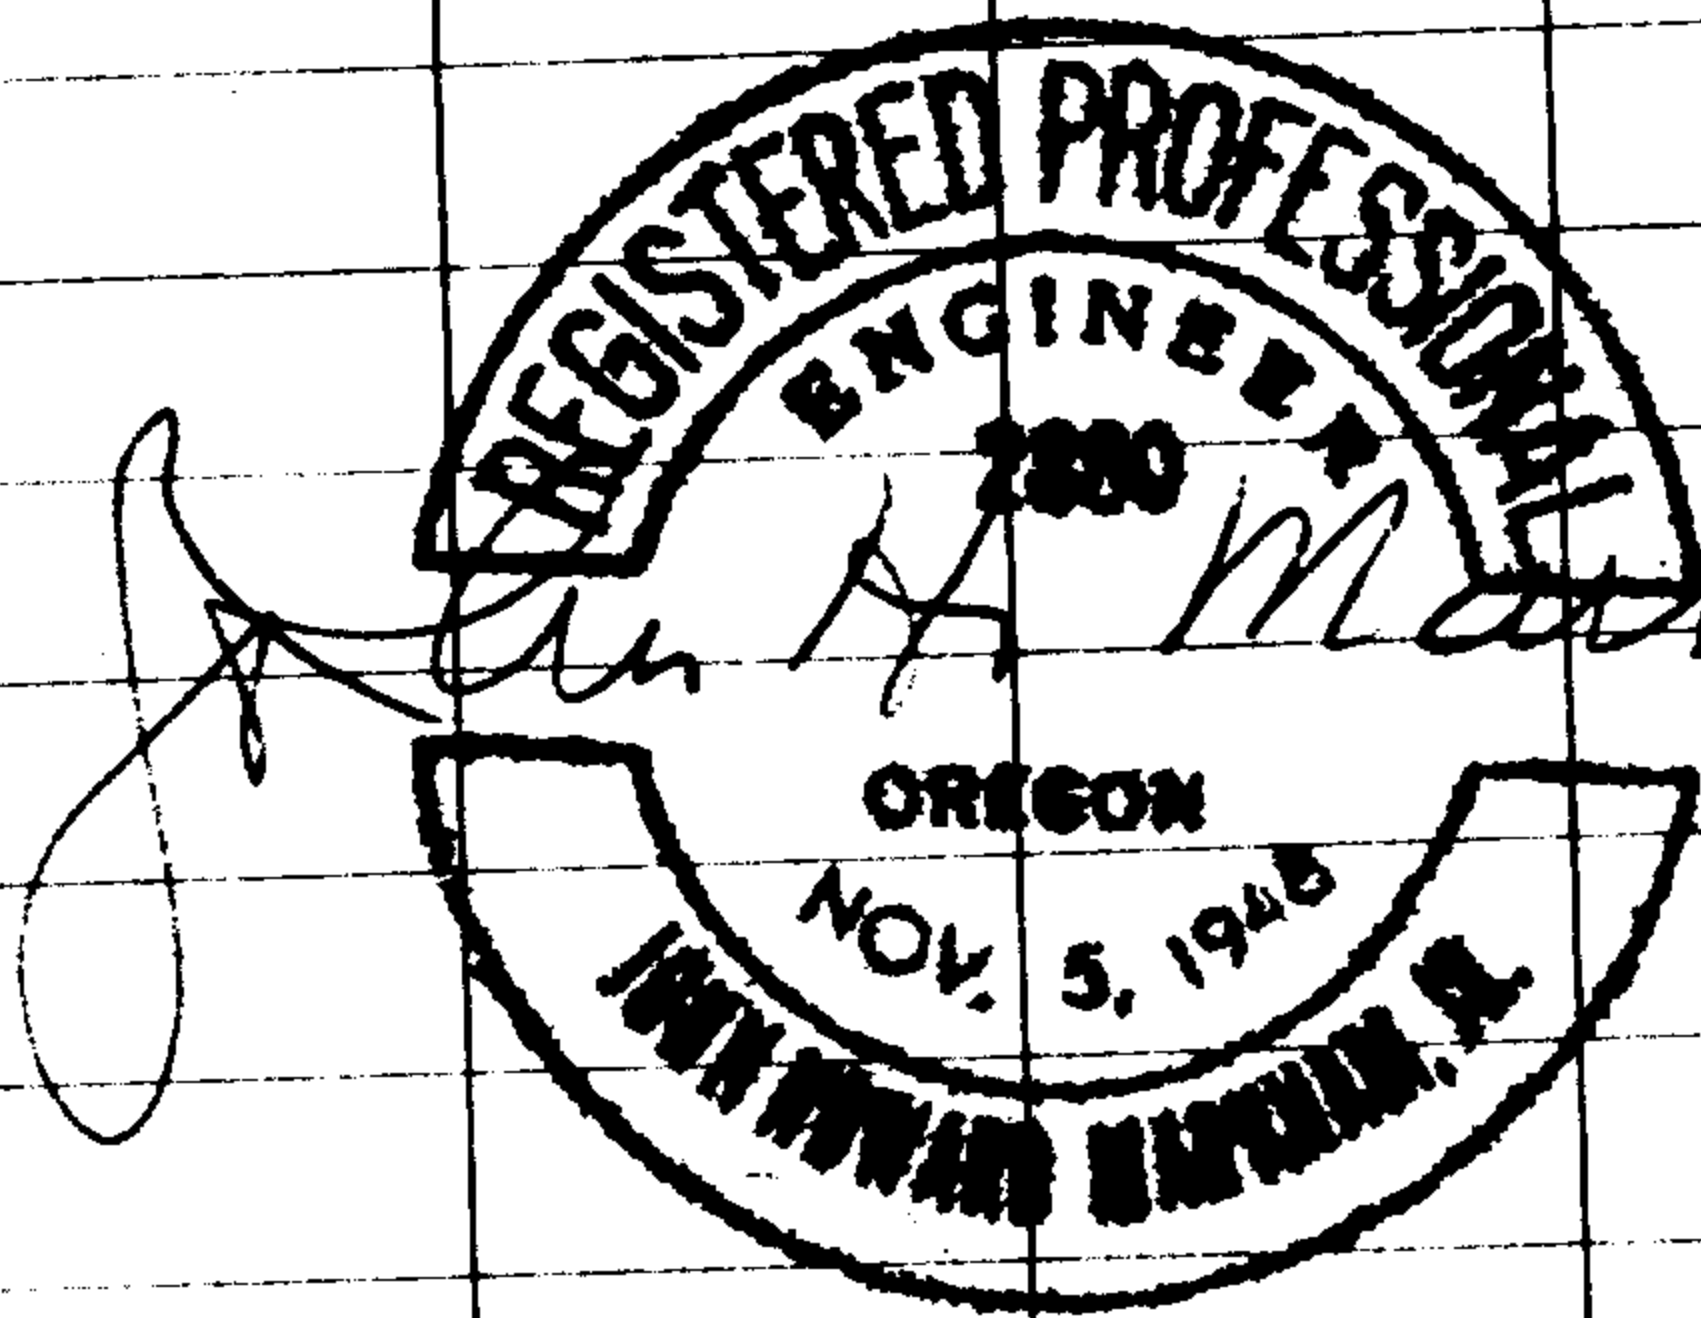

COUNTY SURVEYOR
DOUGLAS COUNTY, ORE.

MAR 10 1952

FILED
RECEIVED

Work done for Stoman Lbr. Co.

S. F. No. 40/386-6