

10-14-51

1/4 Section Corner 17-18 T29S,
R3W, W.N. as determined
by O.B.T.

A La 16" diam. bears N71W,
15.0' dist. O.B.T.

A La 30" diam. bears S5°E,
50.0' dist. O.B.T.

At corner point found
scribed post and set 1" x 30"
I.P. from which


A La 6" diam. bears S50°W, 12.0'
dist. mkd. 1/4 S. 18 B.T.

A Cedar 6" diam. bears S42°E,
mkd. 1/4 S. 17 B.T.

Road bears East 150' dist.

Witness:

Geo + Dennis Vaughn

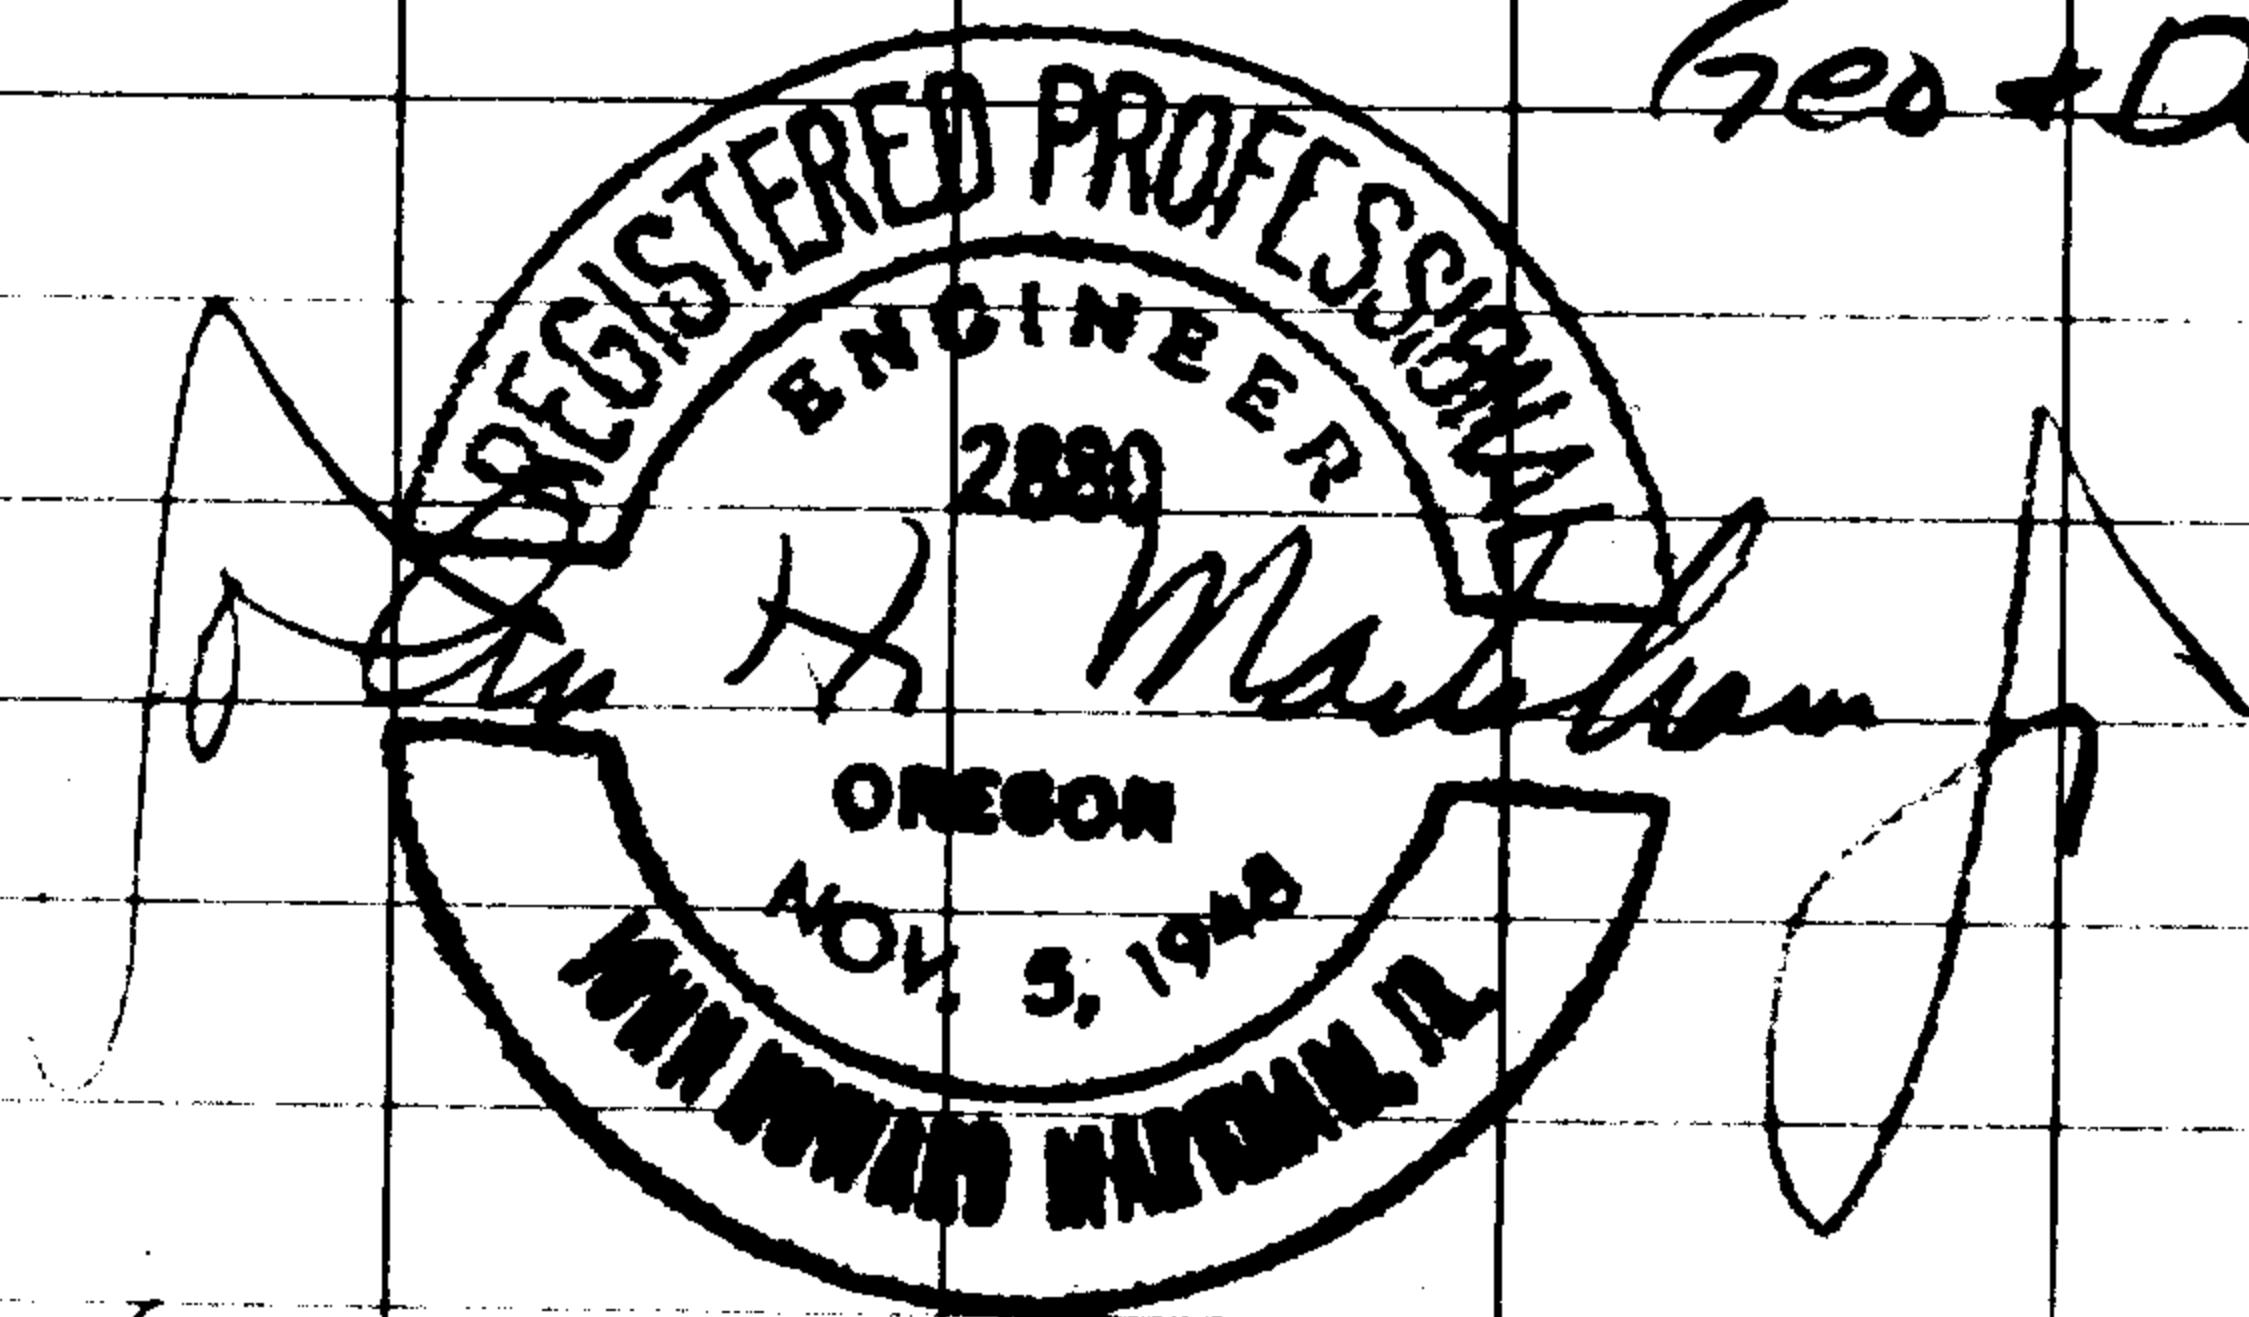

Work done for Stoman Lbr. Co.

C.S. File No. 40/386-7