

11-2-51

South $\frac{1}{4}$ Corner Section 35,
T29S, R4W, W.M. as determined
by O.B.T.

A Fir Stump bears N7E, $14\frac{1}{2}'$
dist. O.B.T. f.d. scribe

A 40" Pine stump bears S4 $\frac{1}{2}$ W,
 $16\frac{1}{2}'$ dist. O.B.T.

At corner point set $1 \times 30"$ I.P.
from which

A Cedar 14" diam. bears N30W,
20.0' dist. mhd. $\frac{1}{4}$ S, 535, B.T.


A Fir 12" diam. bears N57E 61.0'
dist. mhd. $\frac{1}{4}$ S B.T.

Sec. Cor 2-3 bears West, 165.0'

There is a fence running approx.
North + West from $\frac{1}{4}$ cor.

Witness:

Dennis + Geo. Vaughn

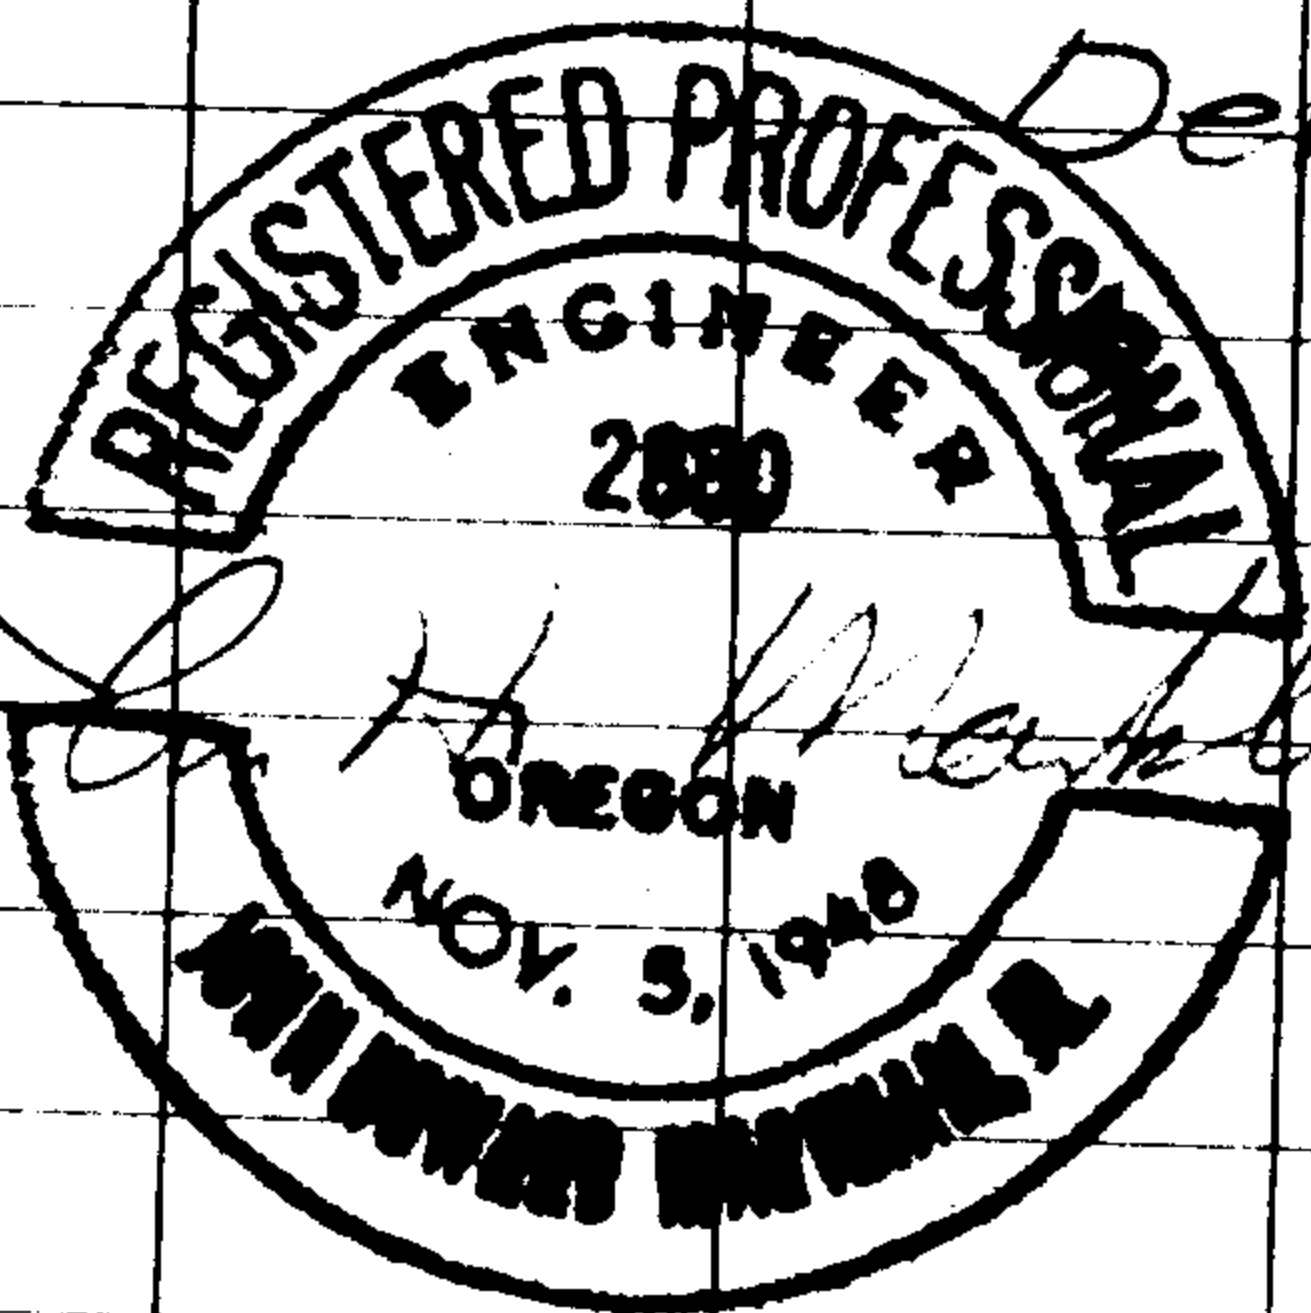

Work done for Stroman Lbr. Co.

S. File No. 40/386-9