

2-6-52

Renewal of renewal
Corner.

S.W. Corner Section 33,
T.29S, R.3W, W.M.

I found all four B.T.'s
but no pipe at corner pt.

I set $\frac{3}{4} \times 30$ " I.P.
from which

A 12" Ash bears $S12^{\circ}E, 48.5'$
dist. mtd. S4, T30S, R3W, B.T.


Days Creek bears South $140.0'$

There are fences bearing
North - South and $S66^{\circ}W$
from corner point.

Witness:

W. E. Markham

E. C. Tracy

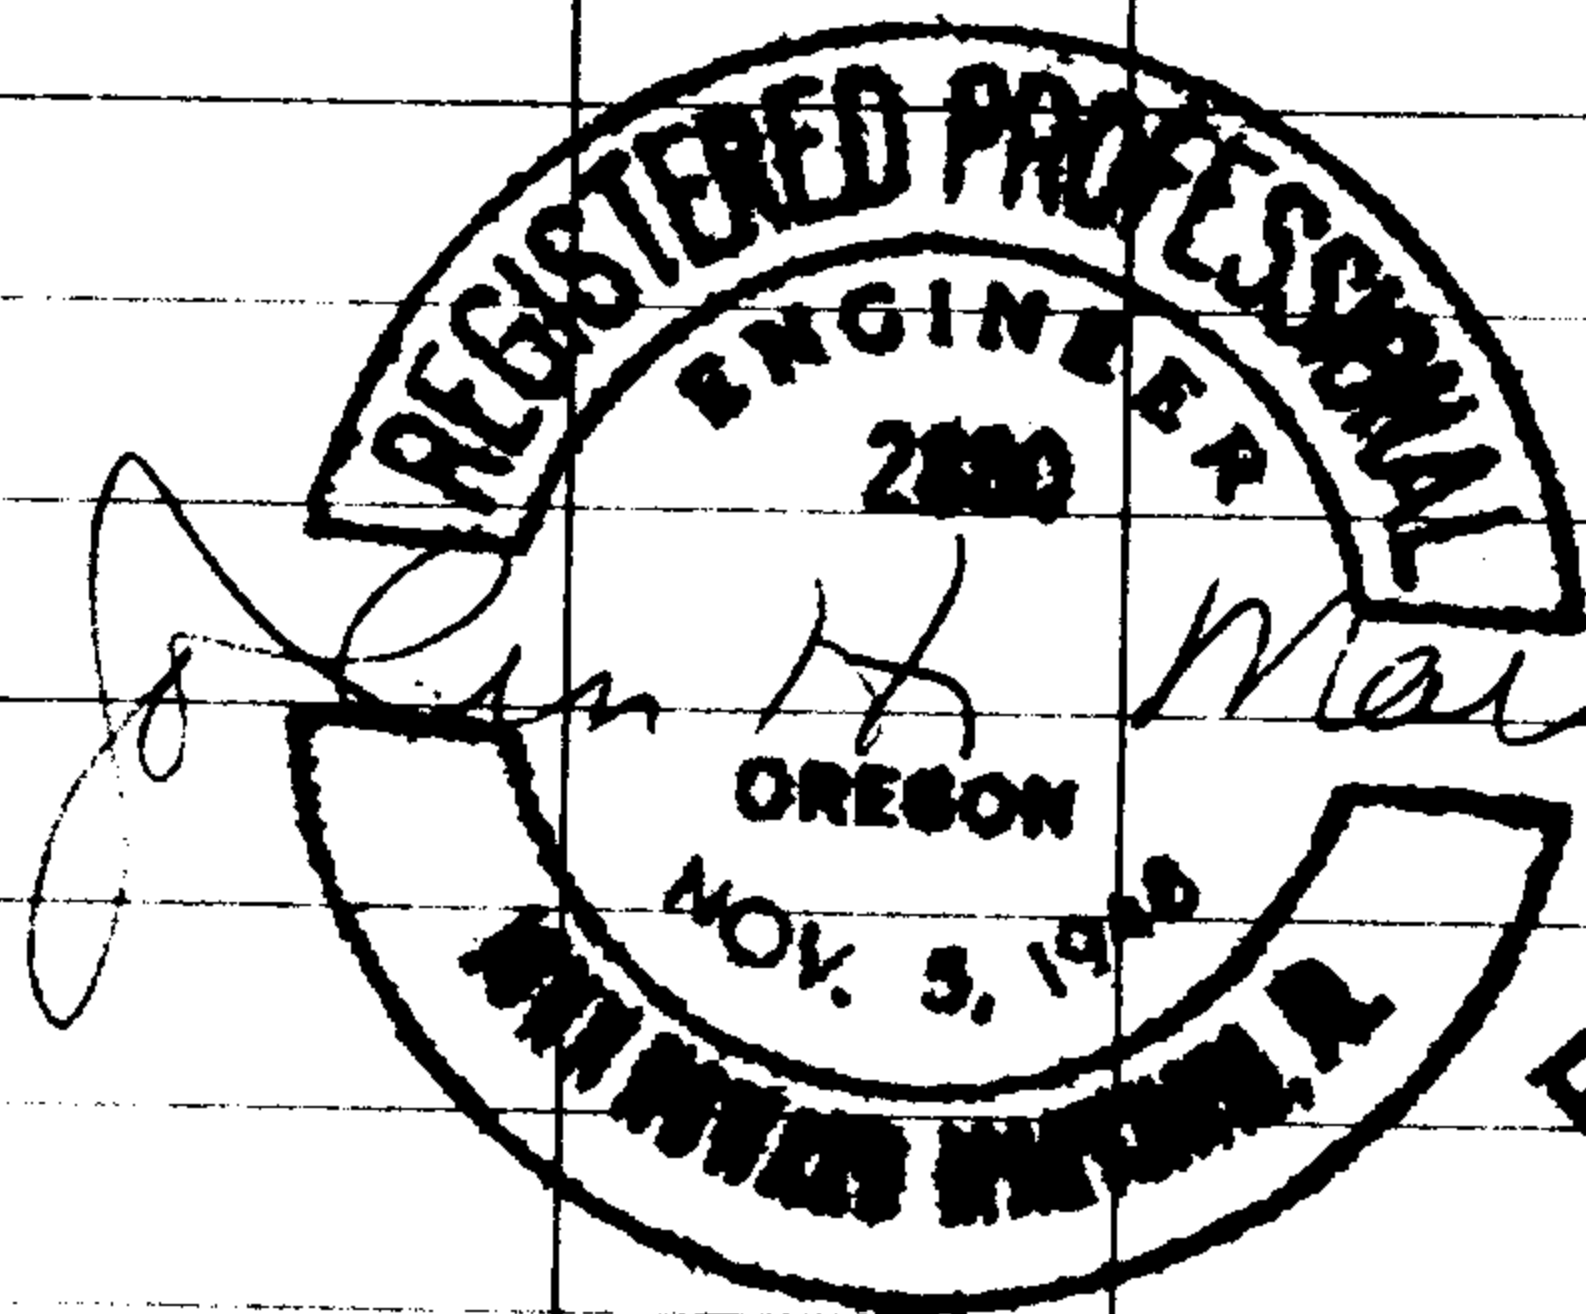

FILED
RECEIVED

FEB 23 1952

CLARENCE SURVEYOR
DOUGLAS COUNTY, ORE.
40-386-10

F40-386

Work done for E. C. Tracy
in connection with Water Right.