


COUNTY SURVEYORS FILE DATA  
DO NOT REMOVE FROM OFFICE

J.P. TAFT PROPERTY  
FAIR ACRES ADDITION  
Township 26S.-R9 6W W.M.  
Scale 1"=100' April 1949

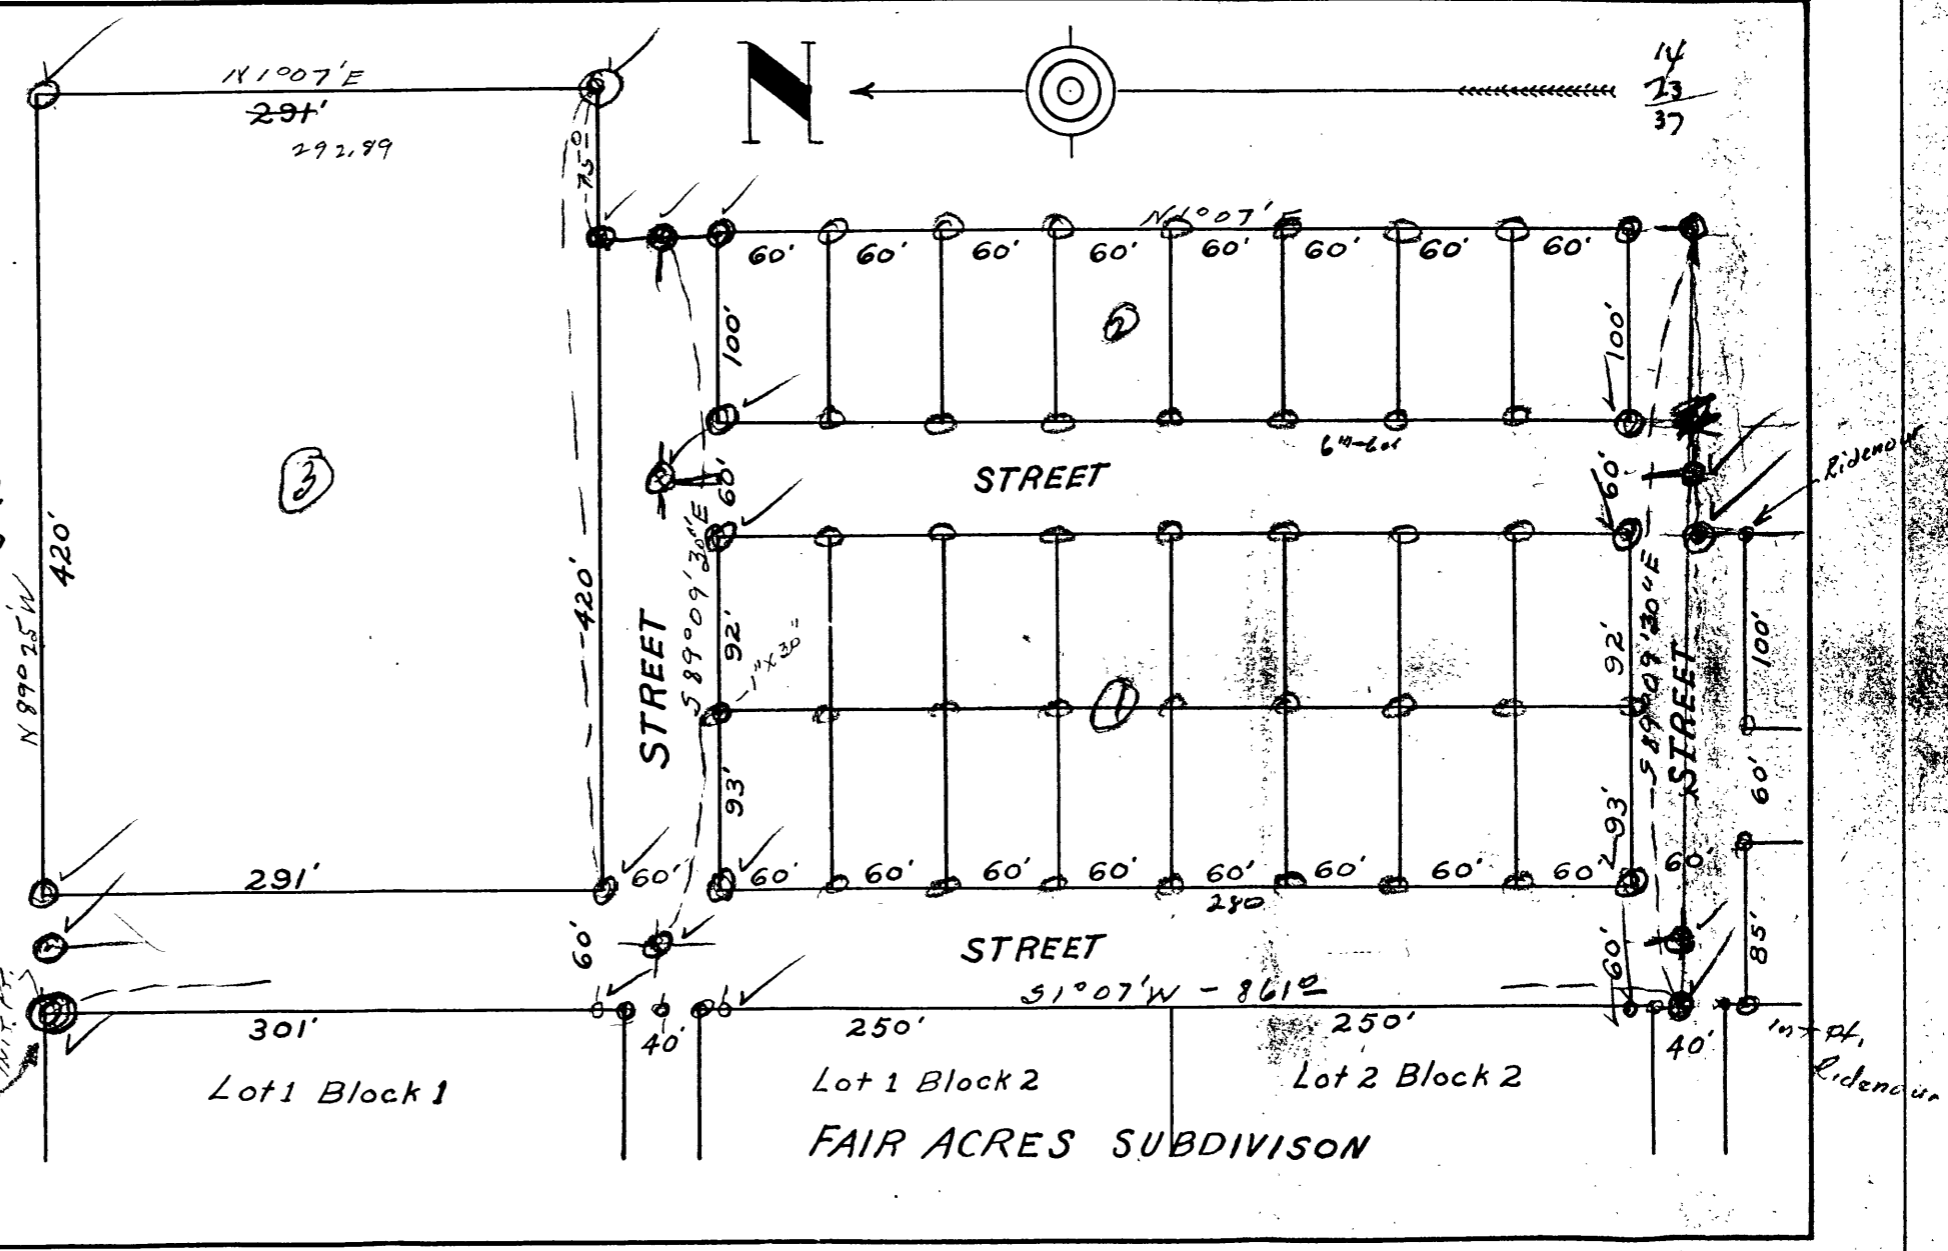

O.S. 70/405

36 AD

(2)