


COUNTY SURVEYORS FILE DATA  
DO NOT REMOVE FROM OFFICE

MAP  
SHOWING LAND PURCHASED  
by  
BRUCE Mc CORMACK  
IN

Lot 8 - Sec. 12 Tp. 27S - Rg. 3W WM.  
Scale - 1" = 200' July 1959.

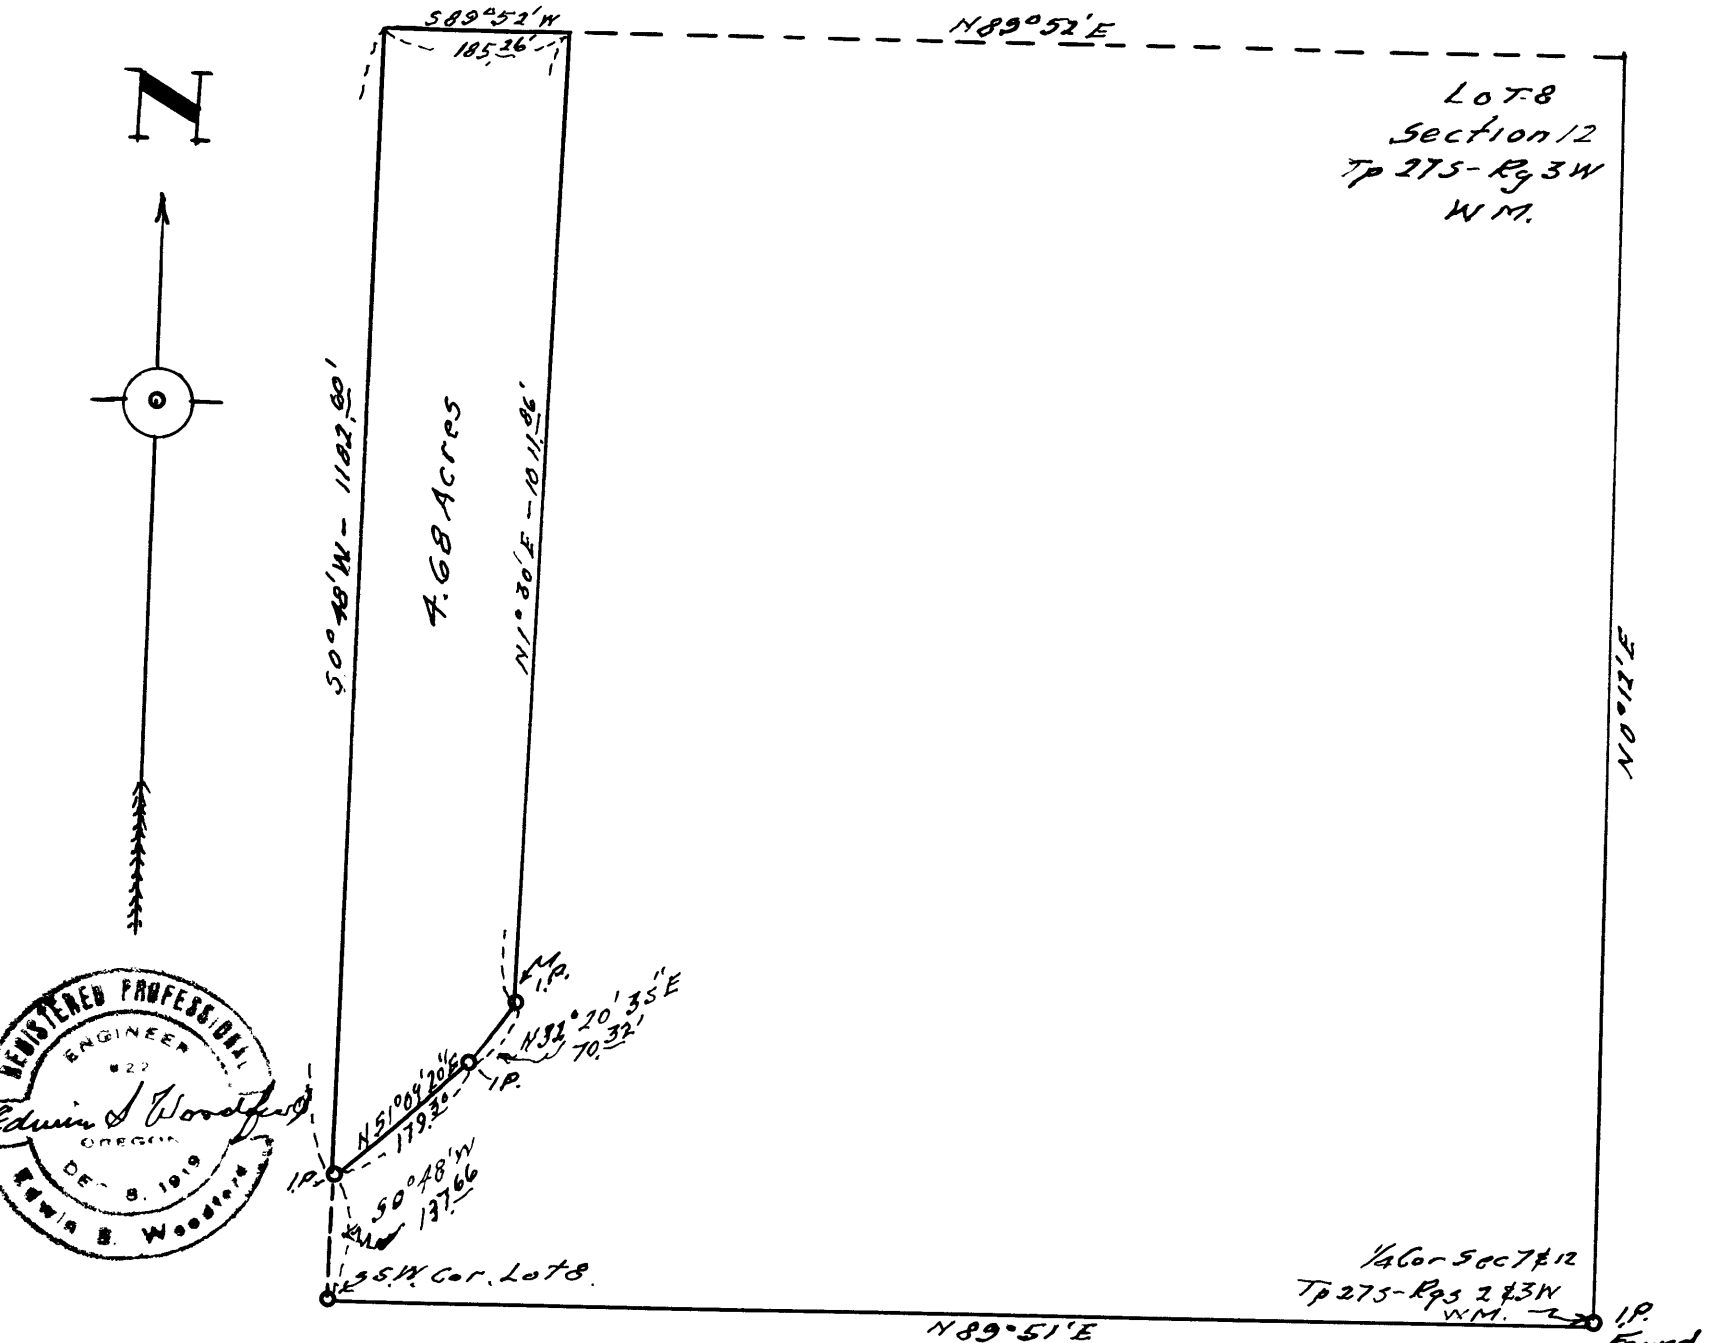

C.S. 40/409