
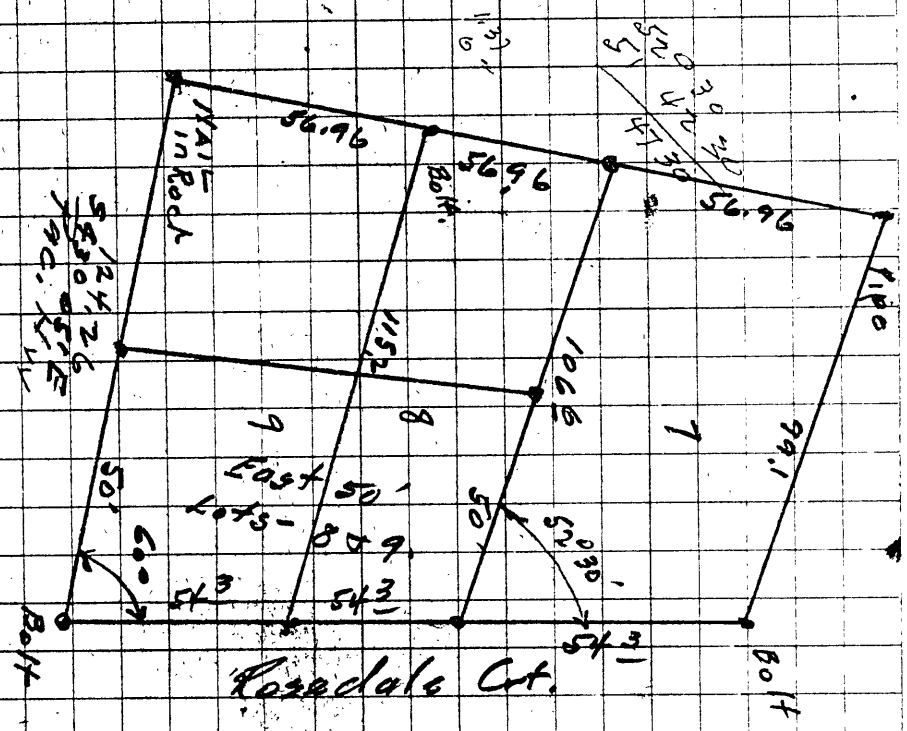


Page - Book - 3
 Survey Records

Tp 27-295. Unsubt
 Lots 8-9 - Blk-4
 Cream Heights

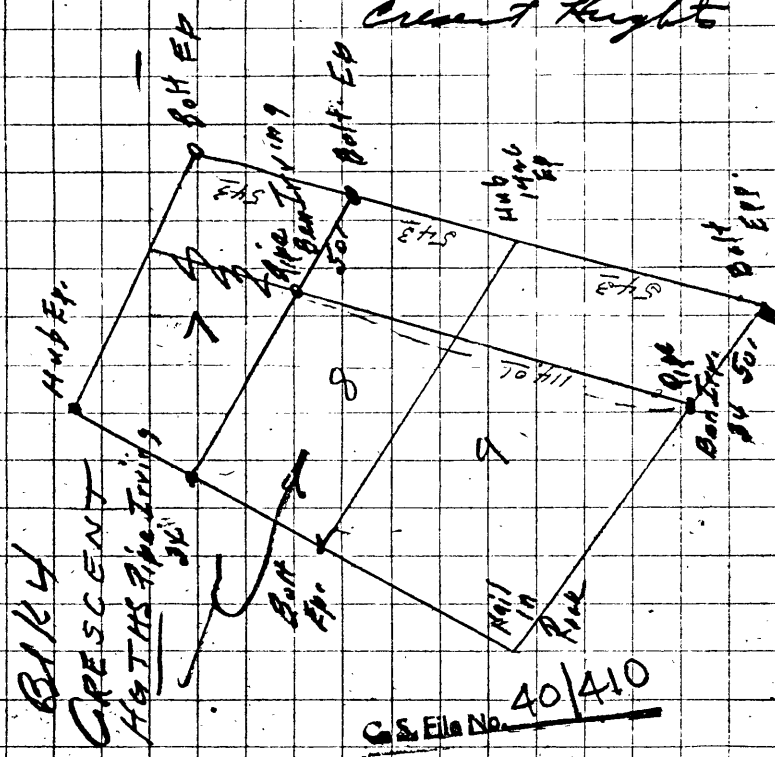

97113
 60023
 291339
 582678
 82969339
 97163600
 5857800
 27150
 427

C.S. File No. 40/410

Fred Bowen & W.F. Carter
 No. 5th Line - Prune St.
 NWY Sta 2497+0.6
 Record Ke. 8-19374

CS FILE FOLDER

CONTAINS

MORE

INFORMATION