

DESCRIPTION

LUELLEN TO KUHN

(Office Copy)


Beginning at a 1/2" x 36" iron pipe on the South line of Lot 2 "West Slopes" subdivision in Section 23, T 27 S R 6 W of W.M.

from which the Southeast corner of said Lot 2 bears East 12.07
 Thence West 60.0 ft. along the South line of said Lot 2 to a 1/2" x 30" iron pipe.

Thence North 89.50 ft. to a 1/2" x 30" iron pipe on the North line of said Lot 2.

(= N 87° 30' E on plat of "West Slopes")
 Thence N 87° 33' E 60.06 ft. along the North line of said Lot 2 to a 1/2" x 30" iron pipe.

Thence South 92.07 ft. to the place of beginning, containing 0.125 acres, (5447 sq. ft.) more or less, all being a part of Lot 2 of "West Slopes" subdivision.

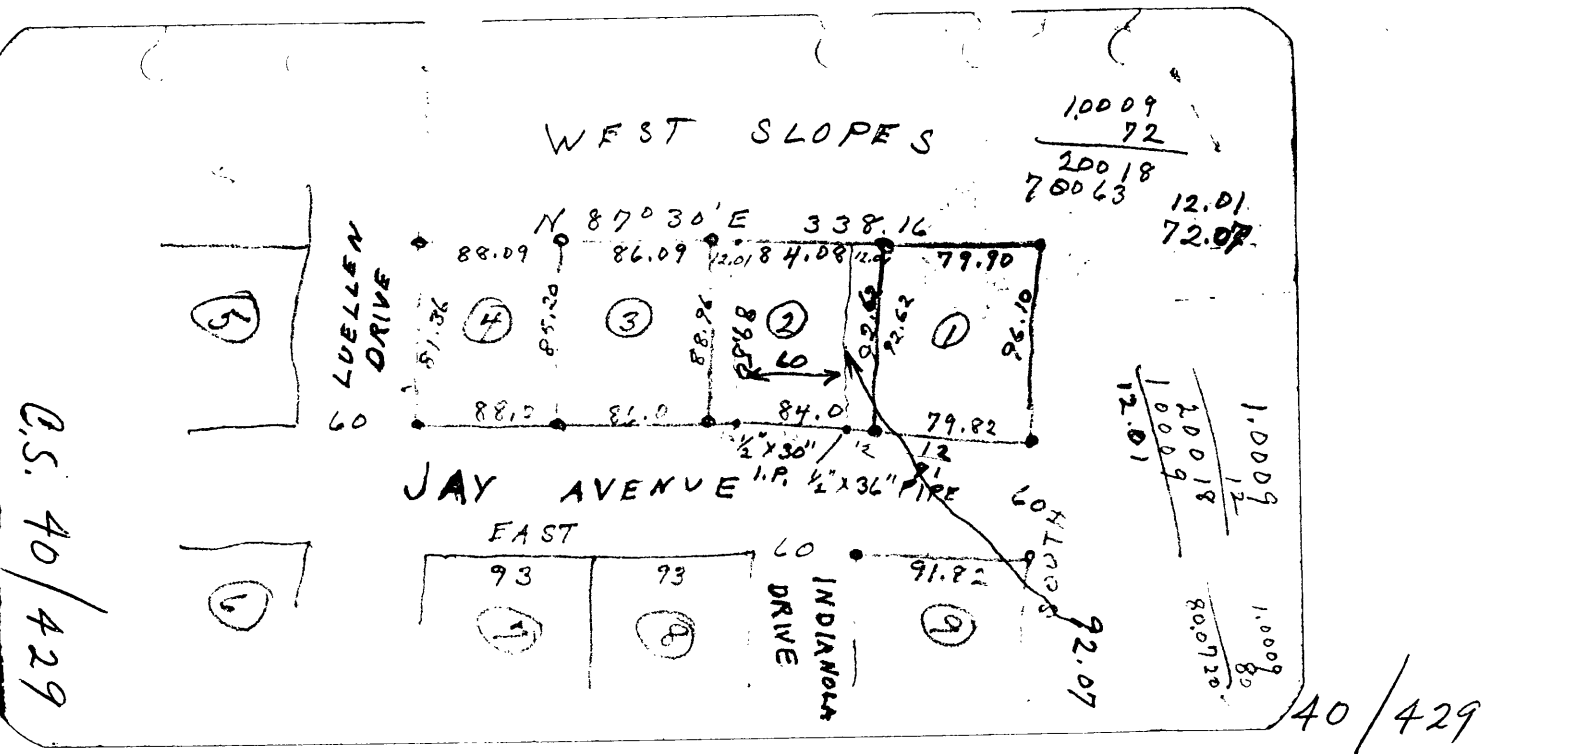

O.S. 40/429

40/429