


A PORTION OF  
E. CROXTON DLC.

TWPS. 28 & 29 S, RANGE 7 W., W.M.

AS SURVEYED FOR M.L. CANFIELD, JULY, 1946.

Scale: 1-inch = 200 ft.

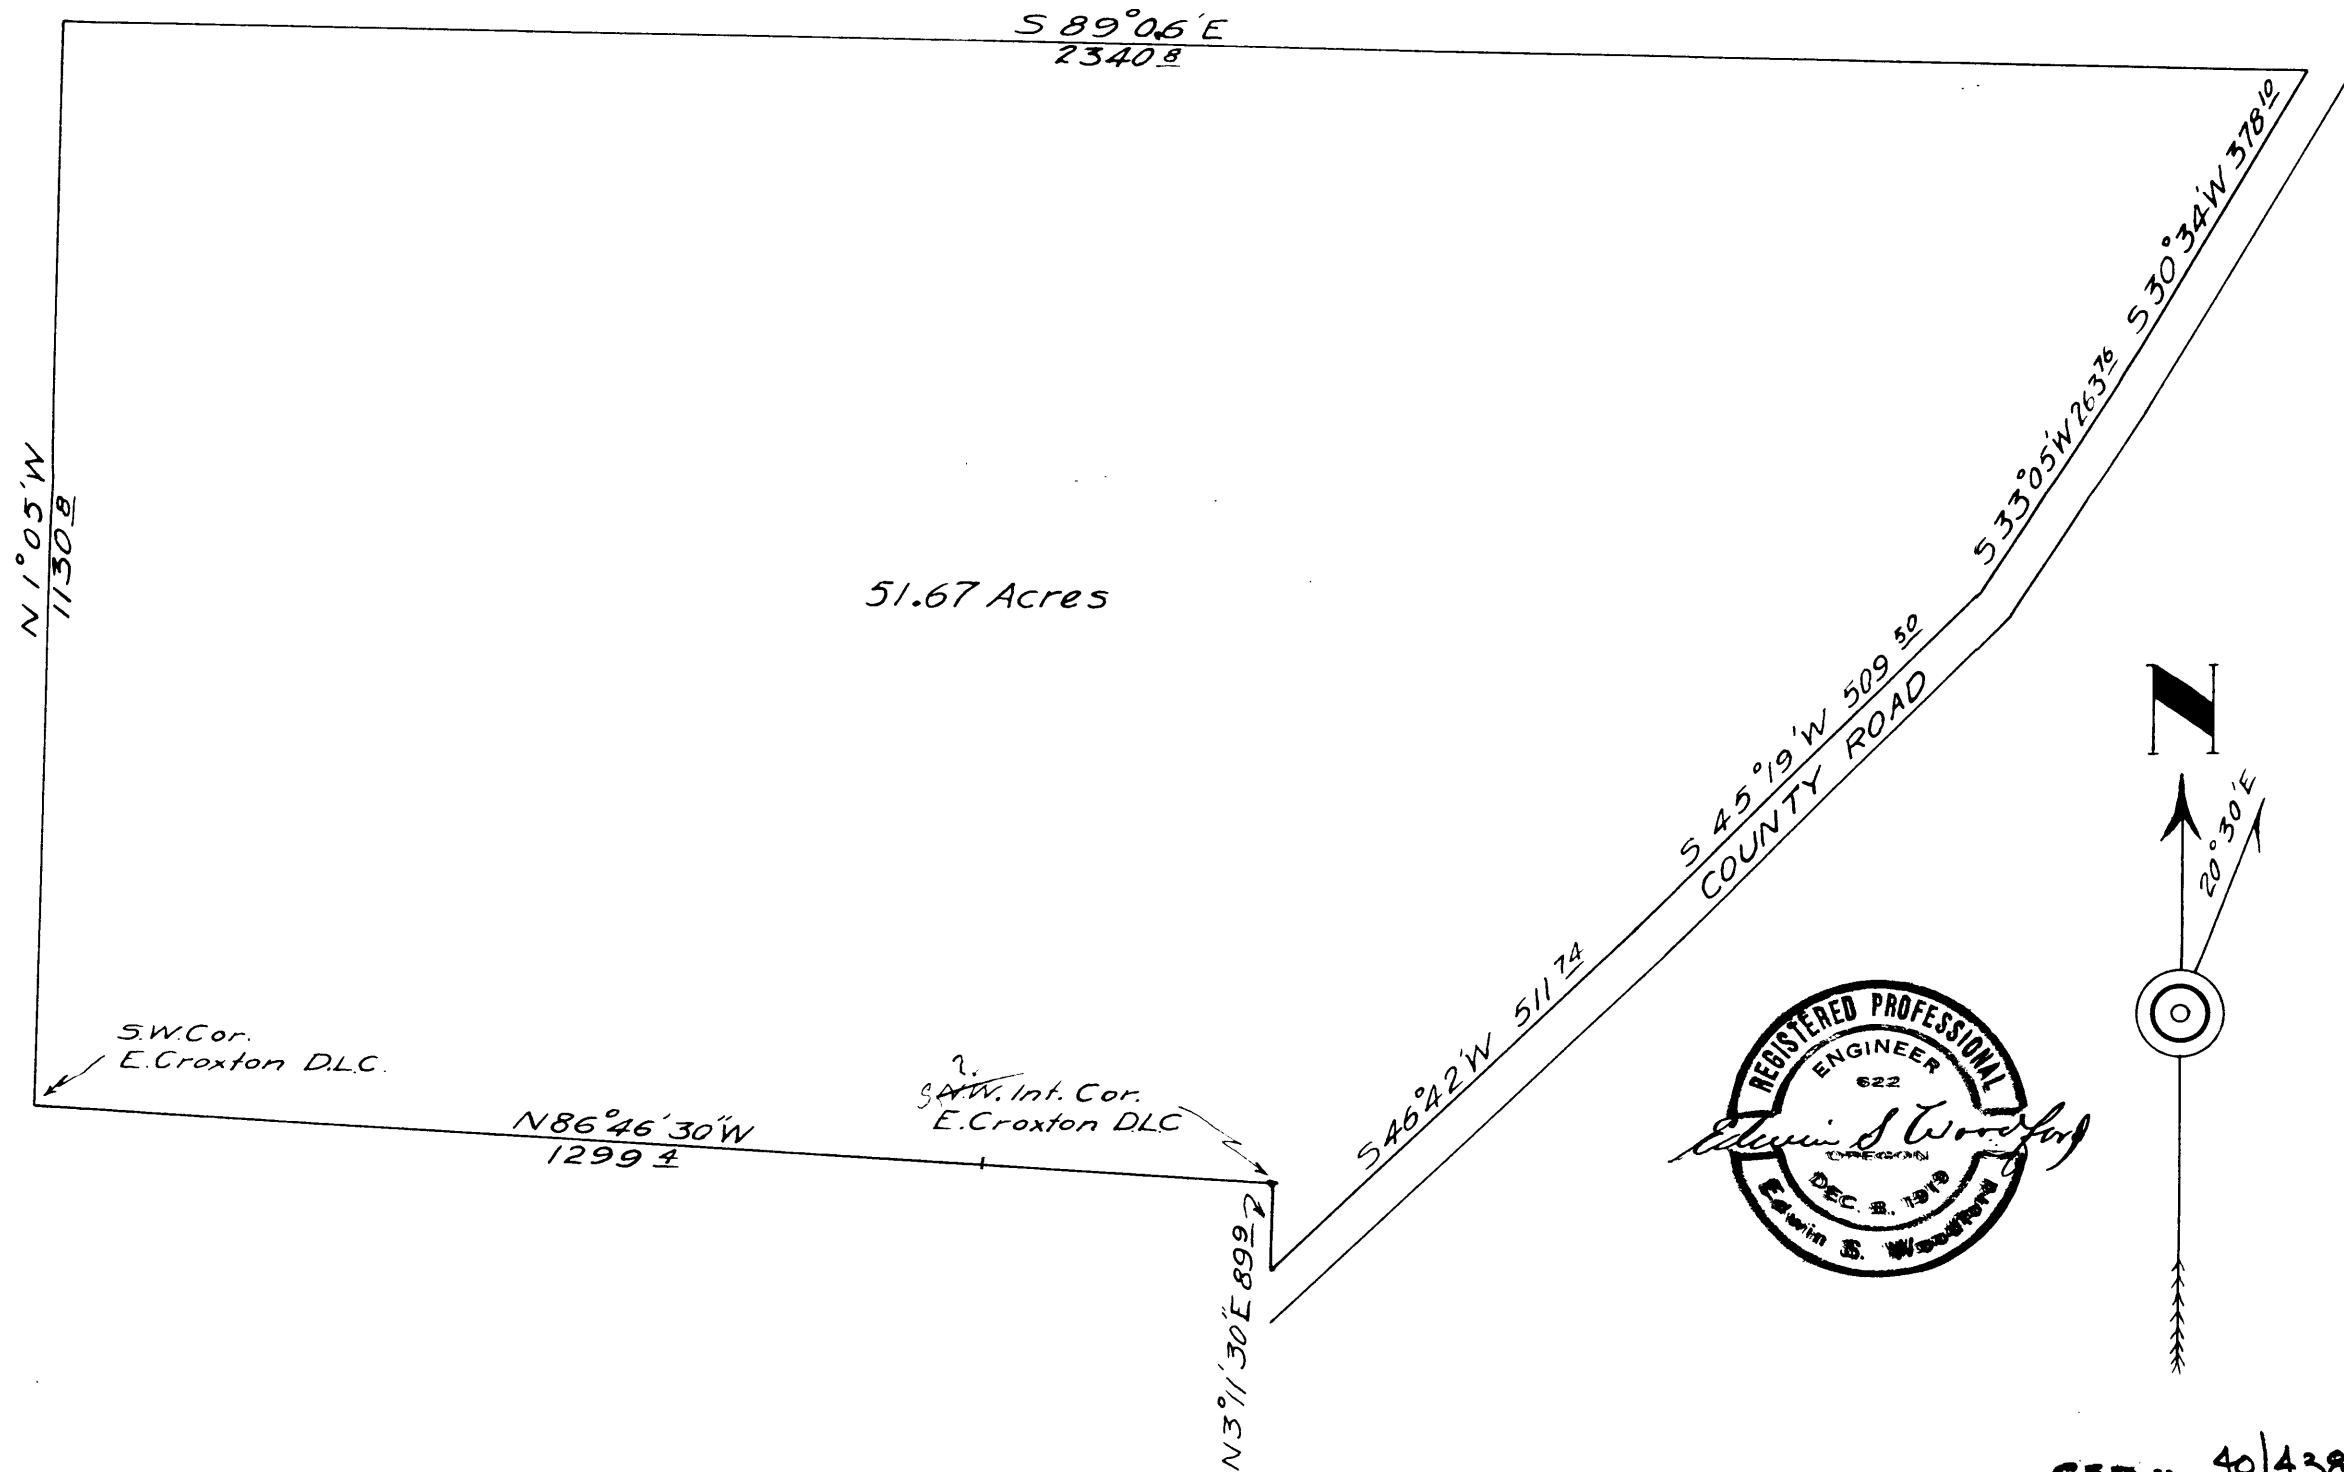

CSM No. 40/438

CS FILE FOLDER

CONTAINS

MORE

INFORMATION