


COUNTY SURVEYORS FILE DATA
DO NOT REMOVE FROM OFFICE

MAP
OF
LANDS SURVEYED
FOR
CECIL HUGH
IN
SEC. 11 - TP. 27 S - RG. 6 W - WIL - MER.
SCALE - 1" = 20'

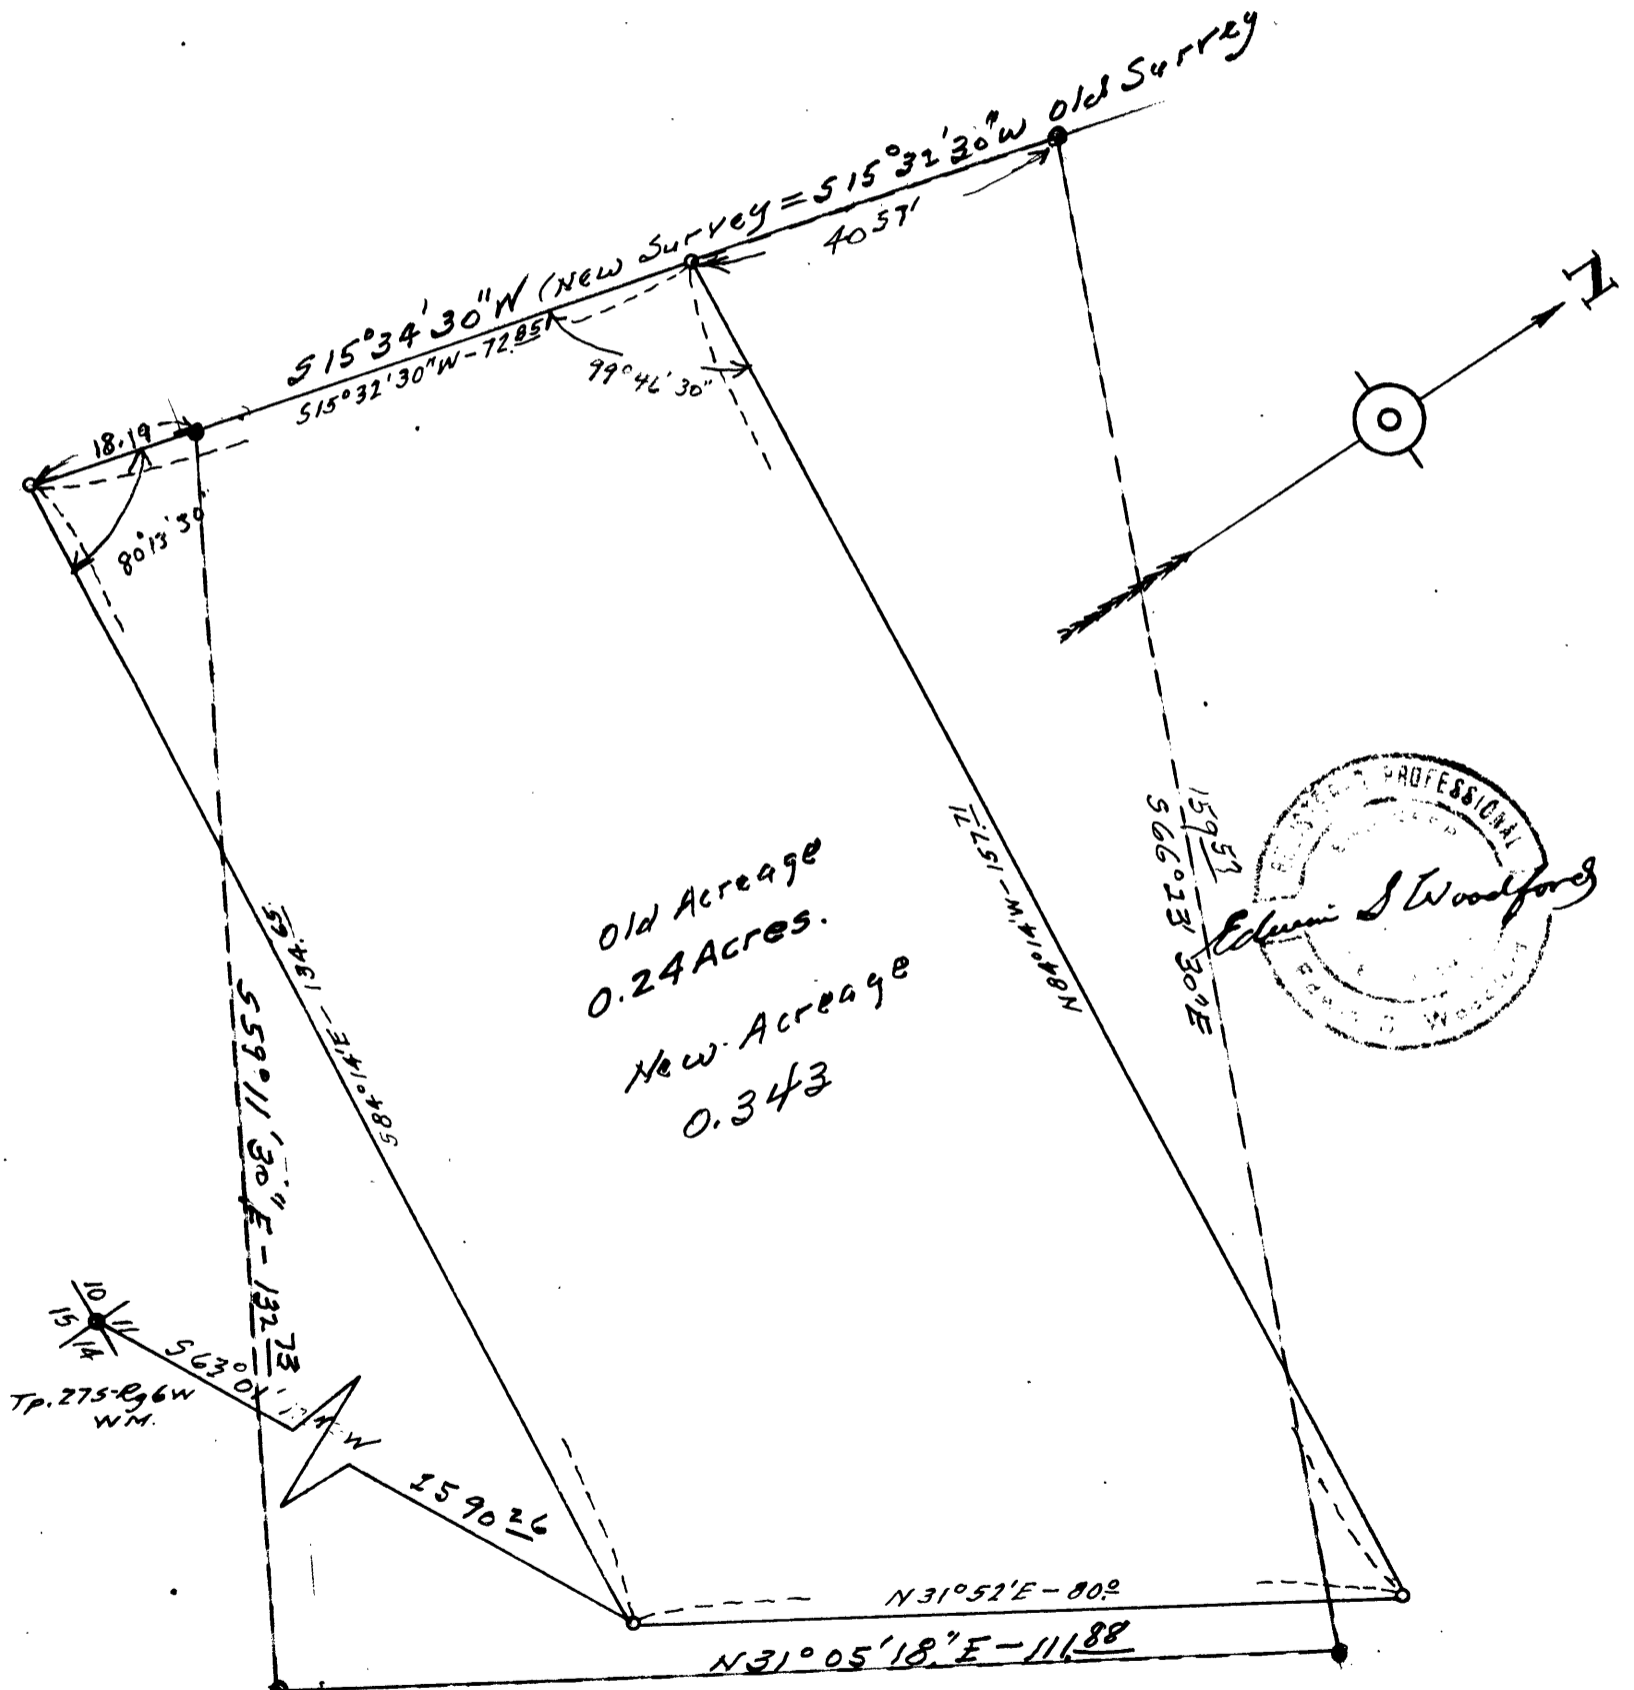

Old Acreage
0.24 Acres.
New Acreage
0.343



CS FILE FOLDER

CONTAINS

MORE

INFORMATION