


NORTH WEST COR.  
JOHN LEISER D.L.C. # 53.  
TP. 275 - RG. 6 W W M.


ROSEBURG - MELROSE Co. Rd.

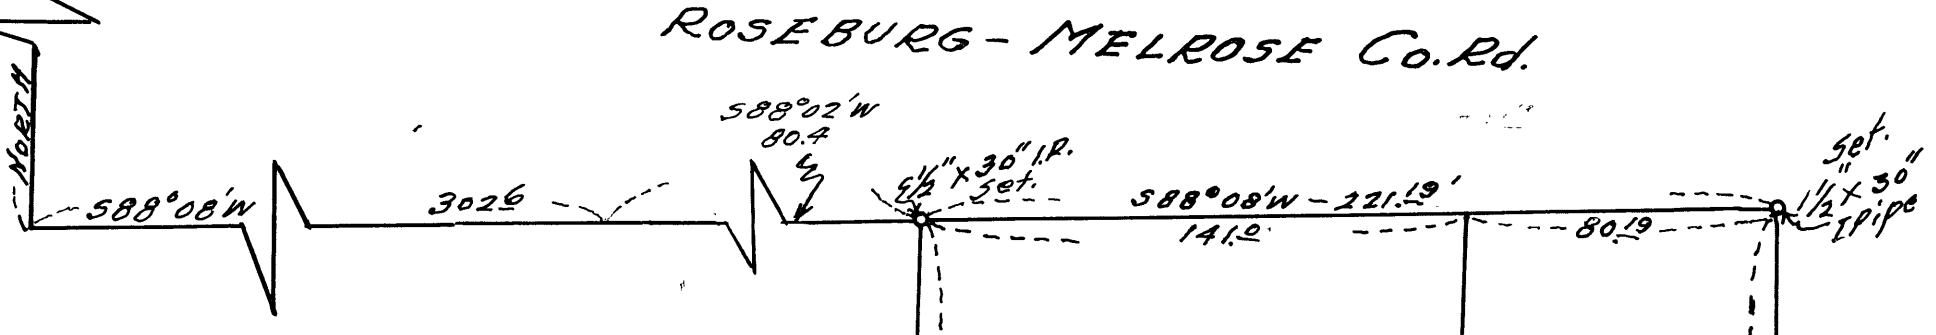

MAP  
OF  
GEORGE KUHN PROPERTY  
IN  
JOHN LEISTER D.L.C # 53.  
TP. 275 - RG. 6 W W M.  
Scale - 1" = 50' APRIL 1956.



South 408.52  
1.320  
Ac.  
South 407.34'  
0.786  
Ac.  
N 0°01'30" W - 406.42'

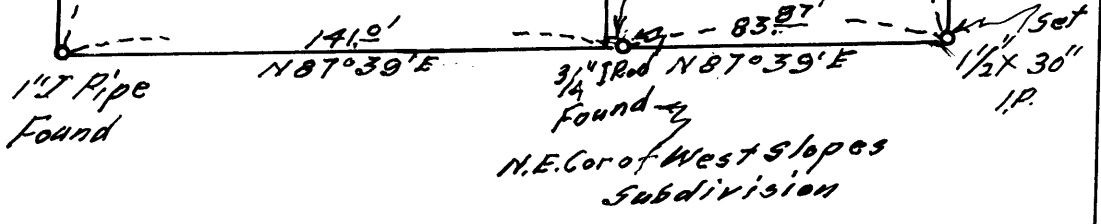

COUNTY SURVEYORS FILE DATA  
DO NOT REMOVE FROM OFFICE

2:11 40/156

CS FILE FOLDER

CONTAINS

MORE

INFORMATION