


MAP
OF
PORTION OF HELGESEN RANCH
IN
SECTION 12 - T. 29 S - R. 6 W W.M.
SCALE - 1" = 100'
AUGUST 1953.

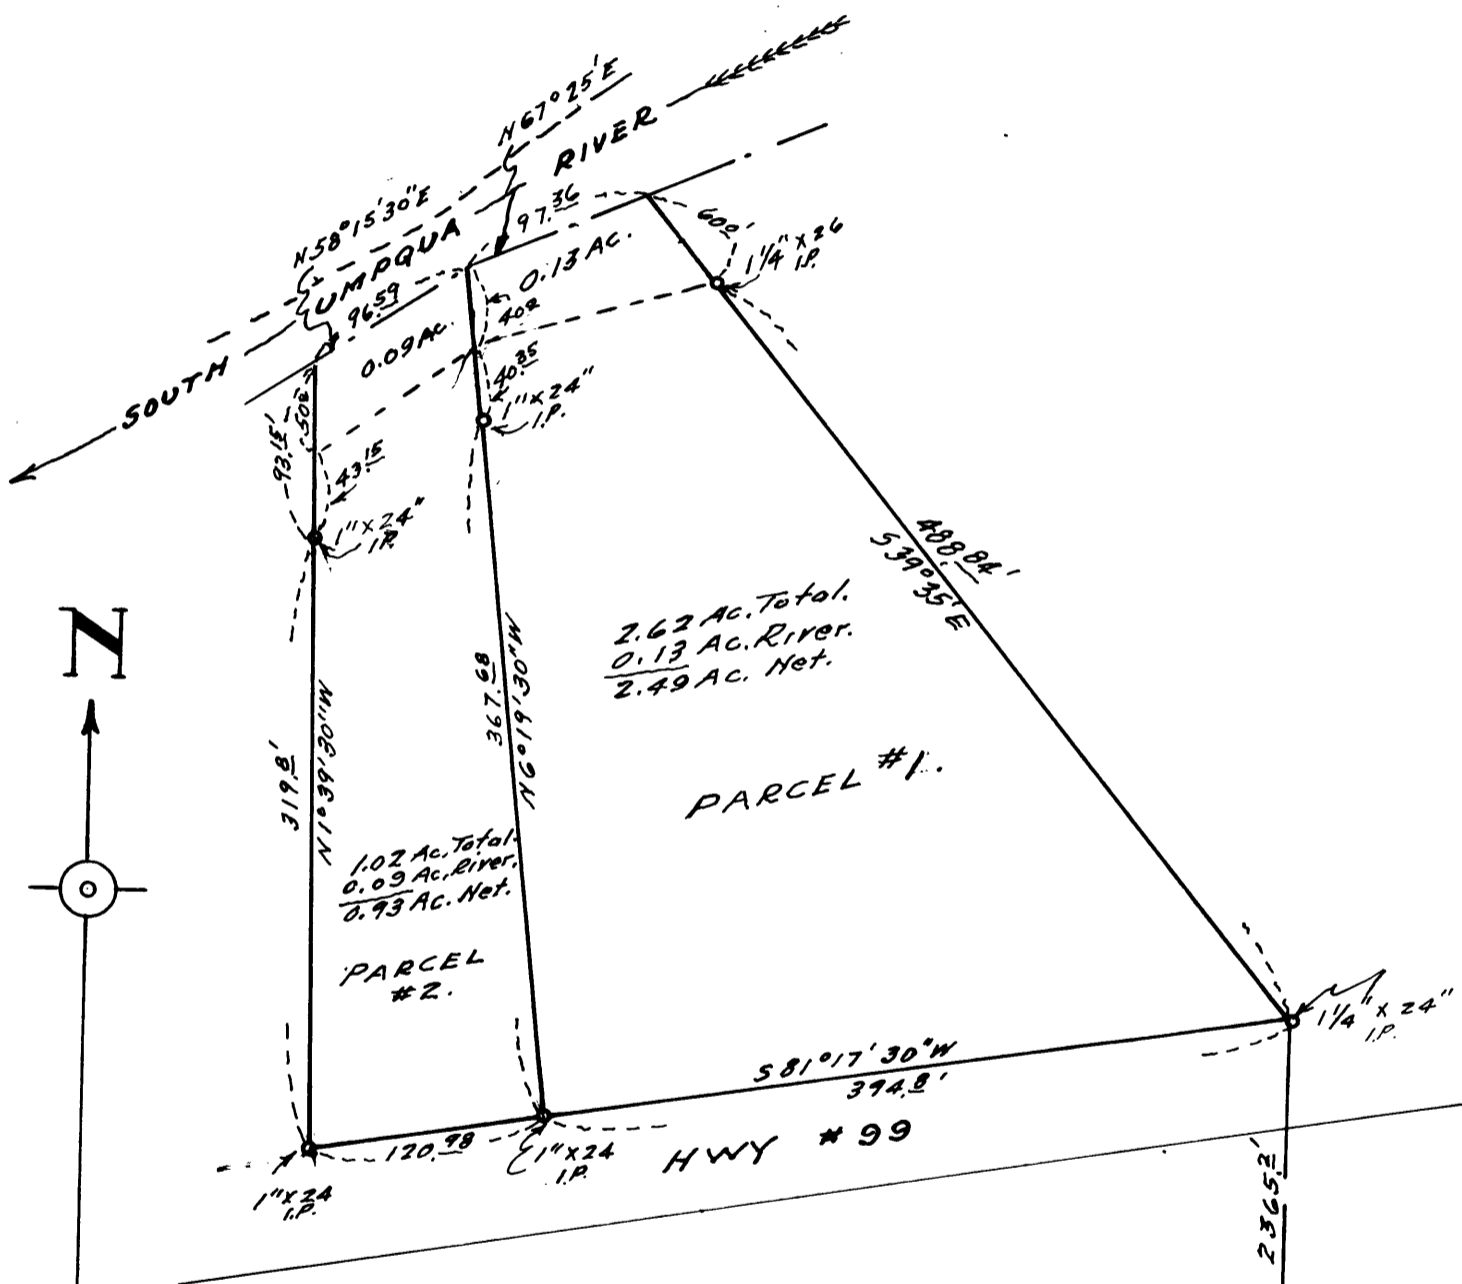

COUNTY SURVEYORS FILE DATA
DO NOT REMOVE FROM OFFICE

SOUTH
EAST 200°
SE Cor Lot 6
Sec. 12 T. 29 S - R. 6 W
W.M.

CS FILE FOLDER

CONTAINS

MORE

INFORMATION