


COUNTY SURVEYORS FILE DATA
DO NOT REMOVE FROM OFFICE

MAP
SHOWING
LAND SURVEYED
IN
SECTION 30 TP. 30S-R6.5W W.M.
Scale - 1" = 50' FEBRUARY 1955.

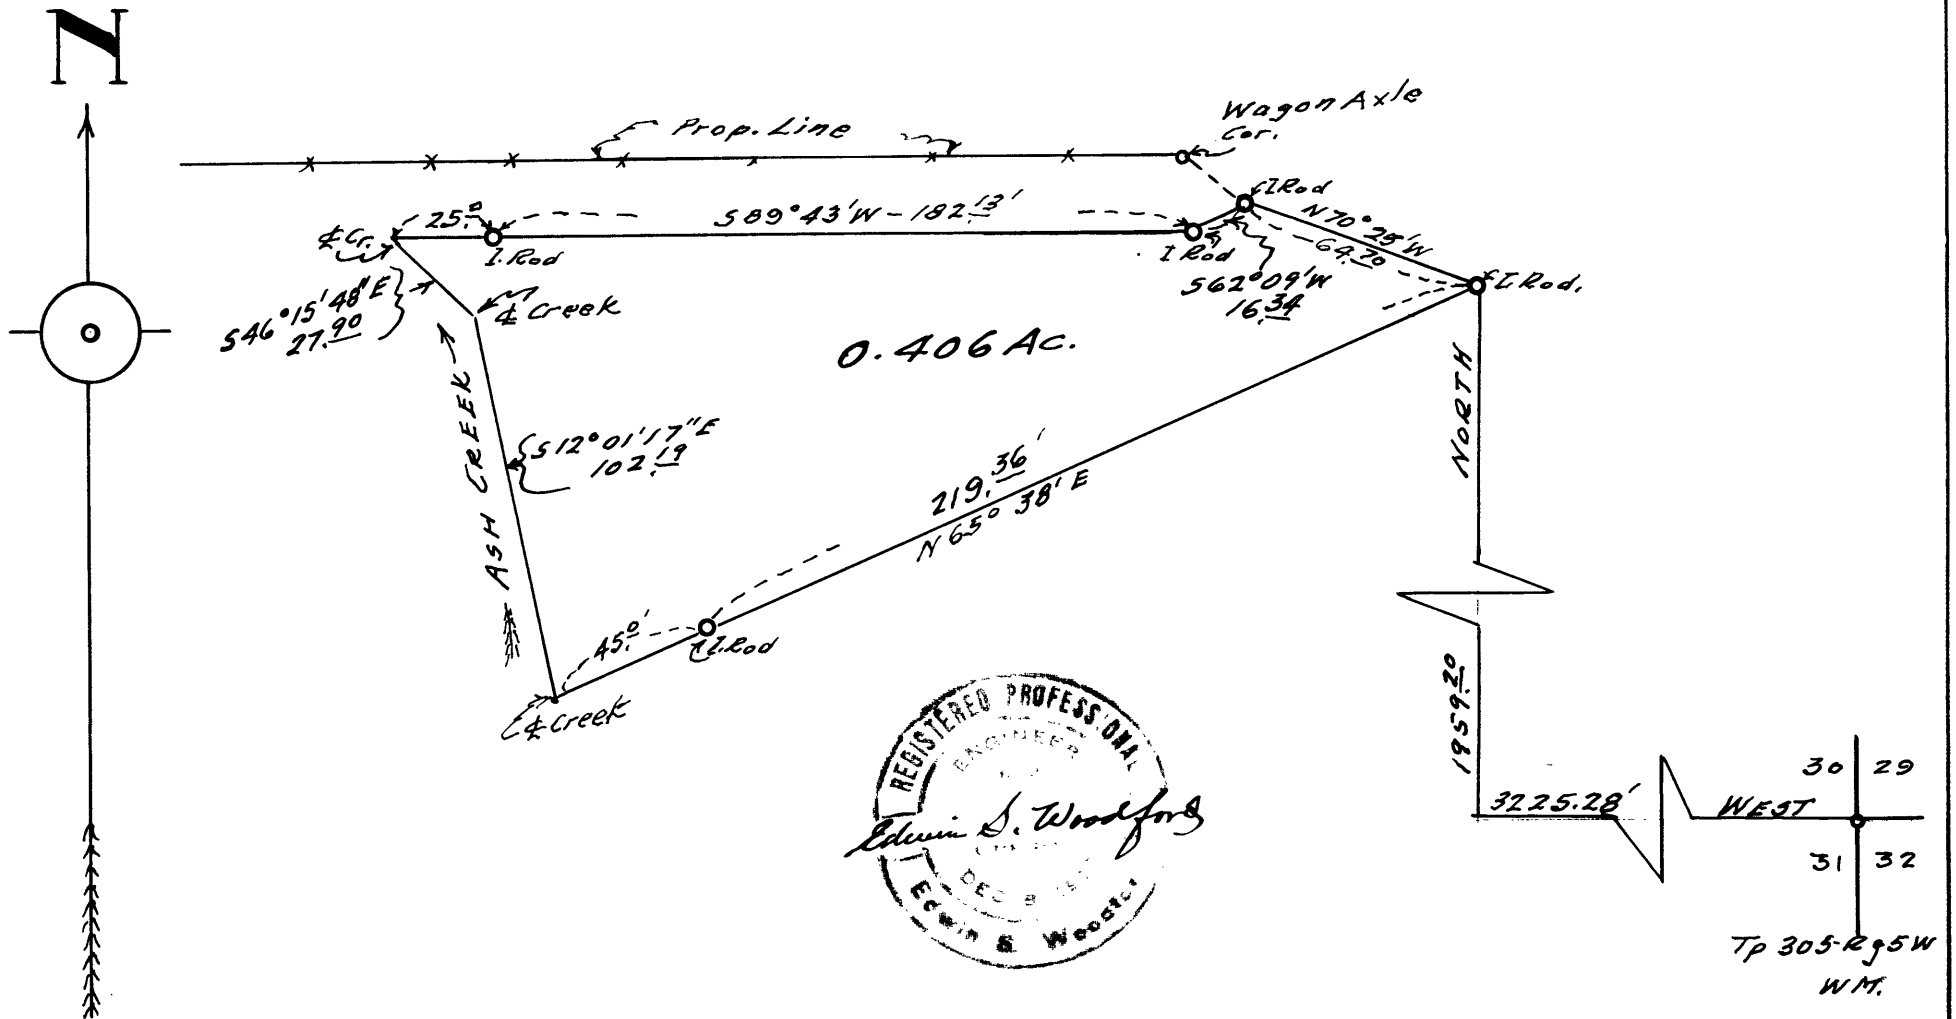

CS 40/465