


File with Co

Surveyed
at
Request
of
Mr. A.C. Brown Camas Valley.
August 1950

**COUNTY SURVEYORS FILE DATA
DO NOT REMOVE FROM OFFICE**

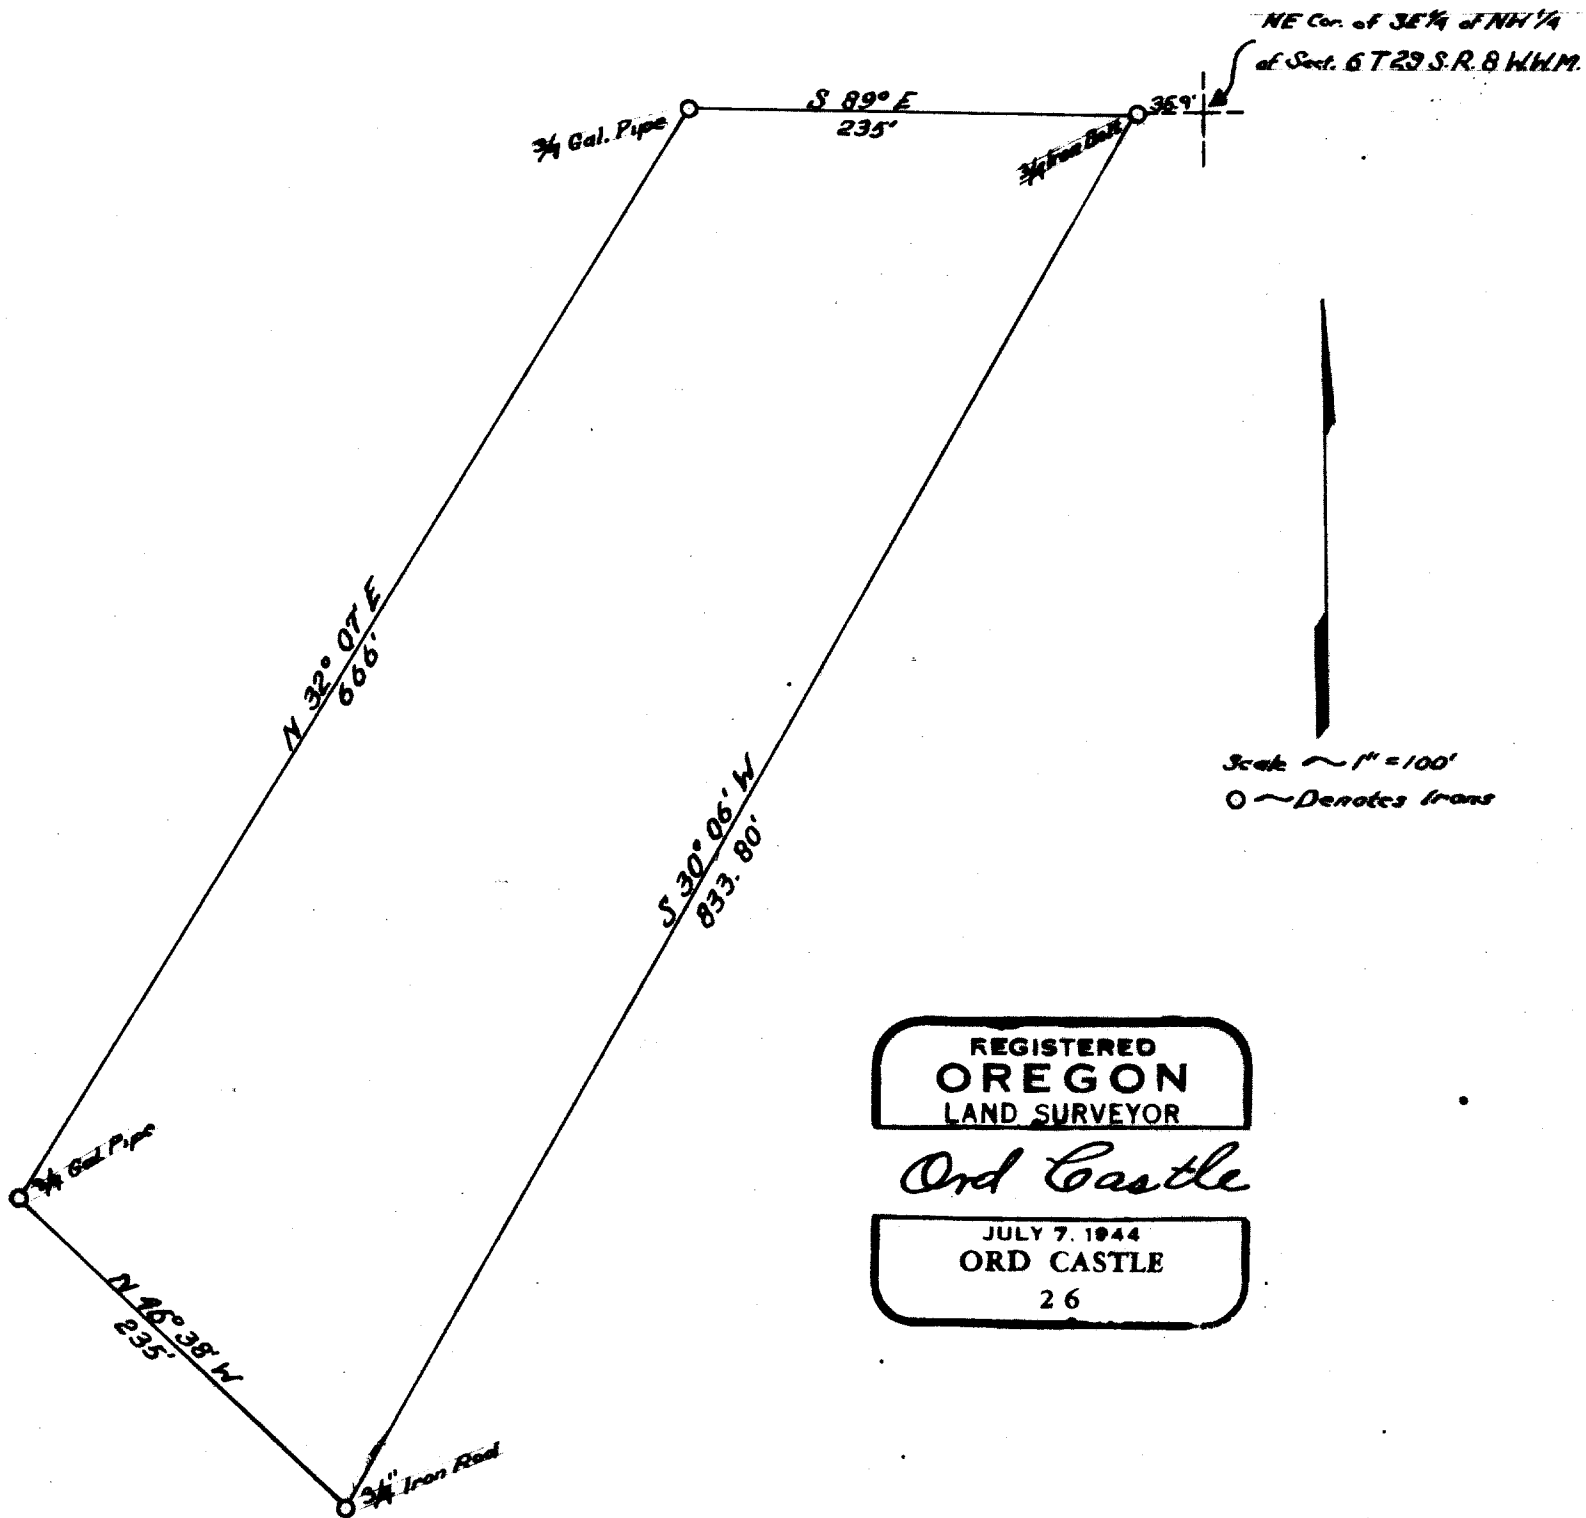

REGISTERED
OREGON
LAND SURVEYOR

Ord Castle

JULY 7, 1944
ORD CASTLE
26