

Cor. Renewals.

① T21S, R5W.

Sec. Cor ~~19/20~~  
30/29

Fd rock with cross per  
gov't field notes.

Bl. & Scribe B.T.

12" Fir,  $S2^{\circ}E$ , 150 $\frac{1}{2}$  ft.

Mkd T21, R5, S-29 RE 2741, B.T.

(only tree available.)

② <sup>30 ~~41/5~~</sup>  
 $\frac{1}{4}$  Cor Secs. 20 & 29, T21S, R5W

Fd Stump of Old B.T.

80" Fir,  $N56^{\circ}E$ , 31 1/2 -

Set  $\frac{1}{2}$ " I.P. for cor.

Bl & Scribed B.T.'s


54" Fir,  $N10^{\circ}W$ , 68 - ft.

Mkd  $\frac{1}{4}$  S-30, RE 2741, B.T.

6" Laurel,  $S52\frac{1}{2}^{\circ}E$ , 240 ft.

Mkd  $\frac{1}{4}$  S-29, RE 2741, B.T.  
(over).

S. File No. 41/5

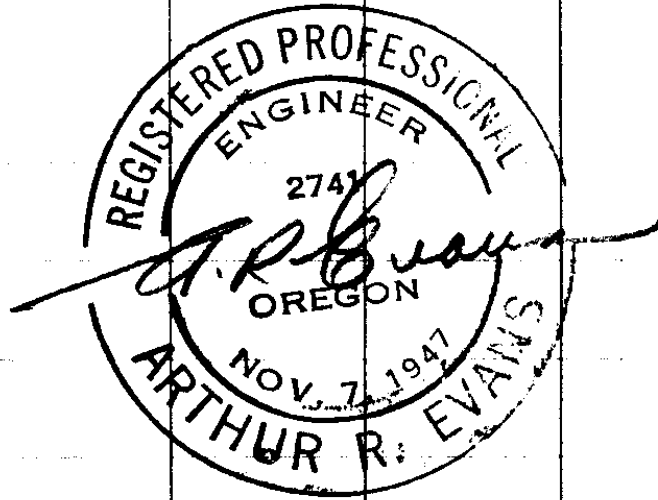

Witnesses;

J. I. Clinton.

John Wooley.

Sept. 1951.

FILED

RECEIVED

FEB 25 1952

COUNTY SURVEYOR

DOUGLAS COUNTY, ORE.

e.s. 41/5