

②

E $\frac{1}{4}$ Cor, Sec. 20, T23S, R9W.
 Fd. 60" Fir, 55° W, 43 lks,
 evidently intended for 60"
 Cherry recorded in govt
 field notes. Very old bark
 blaze, faces properly. Top
 rescribed, but B.T. scribe
 very old. Topography fits
 very well.

Set 1" iron pipe for corner.

③

$\frac{1}{4}$ Cor. 19 & 20, T23S, R9W.


Location determined by
 testimony of A. O. Gustafson
 who has seen original stake
 in place.

Set 1" I.P. for corner. Bl. & Scr B.T.'s

10" Alder, $S60^{\circ}E$, 60 ft.

12" Alder, $N50^{\circ}E$, 25 ft (no suitable trees
 in Sec. 19.)

2
Cor. Renewals in Sec 29, T43S, R9W

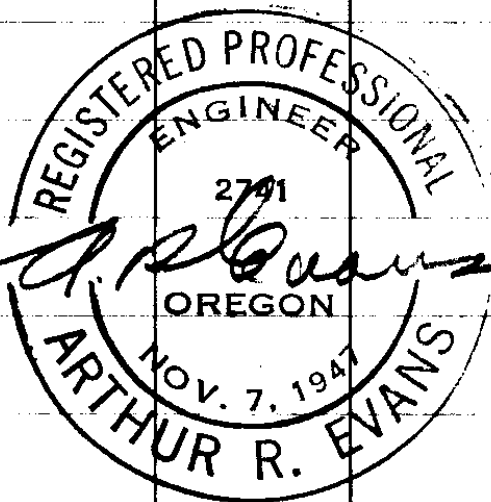

Witnesses:

J. I. Clinton.

Elvin DeGnath.

NOV. 1951.

FILED
RECEIVED

FEB 25 1952

COUNTY SURVEYOR
DOUGLAS COUNTY, ORE.

C. S. File No. 416