

Cor. Renewals.

①

$\frac{1}{4}$ cor Secs. 10-15, T26S, R2W.

Set $\frac{1}{2}$ " iron pipe for corner
by prop. meas.

B.L. & Scr. 2 B.T.s.

8" Fir, S 1038' W, 174 ft.

Mkd. $\frac{1}{4}$ S-W, B.T.

12" Fir, N 67033' W, 156 ft.

Mkd $\frac{1}{4}$ S-10 B.T.

(Bearings & distances to
Copper tags & State tags


in roots. — face of B.T. blaze.

Copper tags marked RE 2791.

Witnesses:

J. I. Clinton.

Geo. Kuhn.

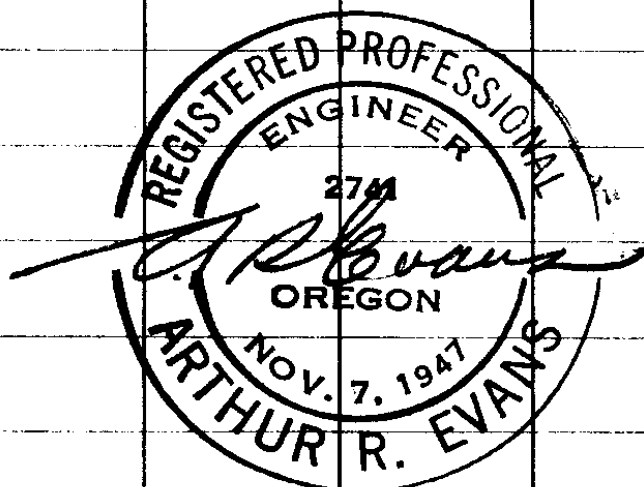

C. S. File No. 418