


Claude Mesner

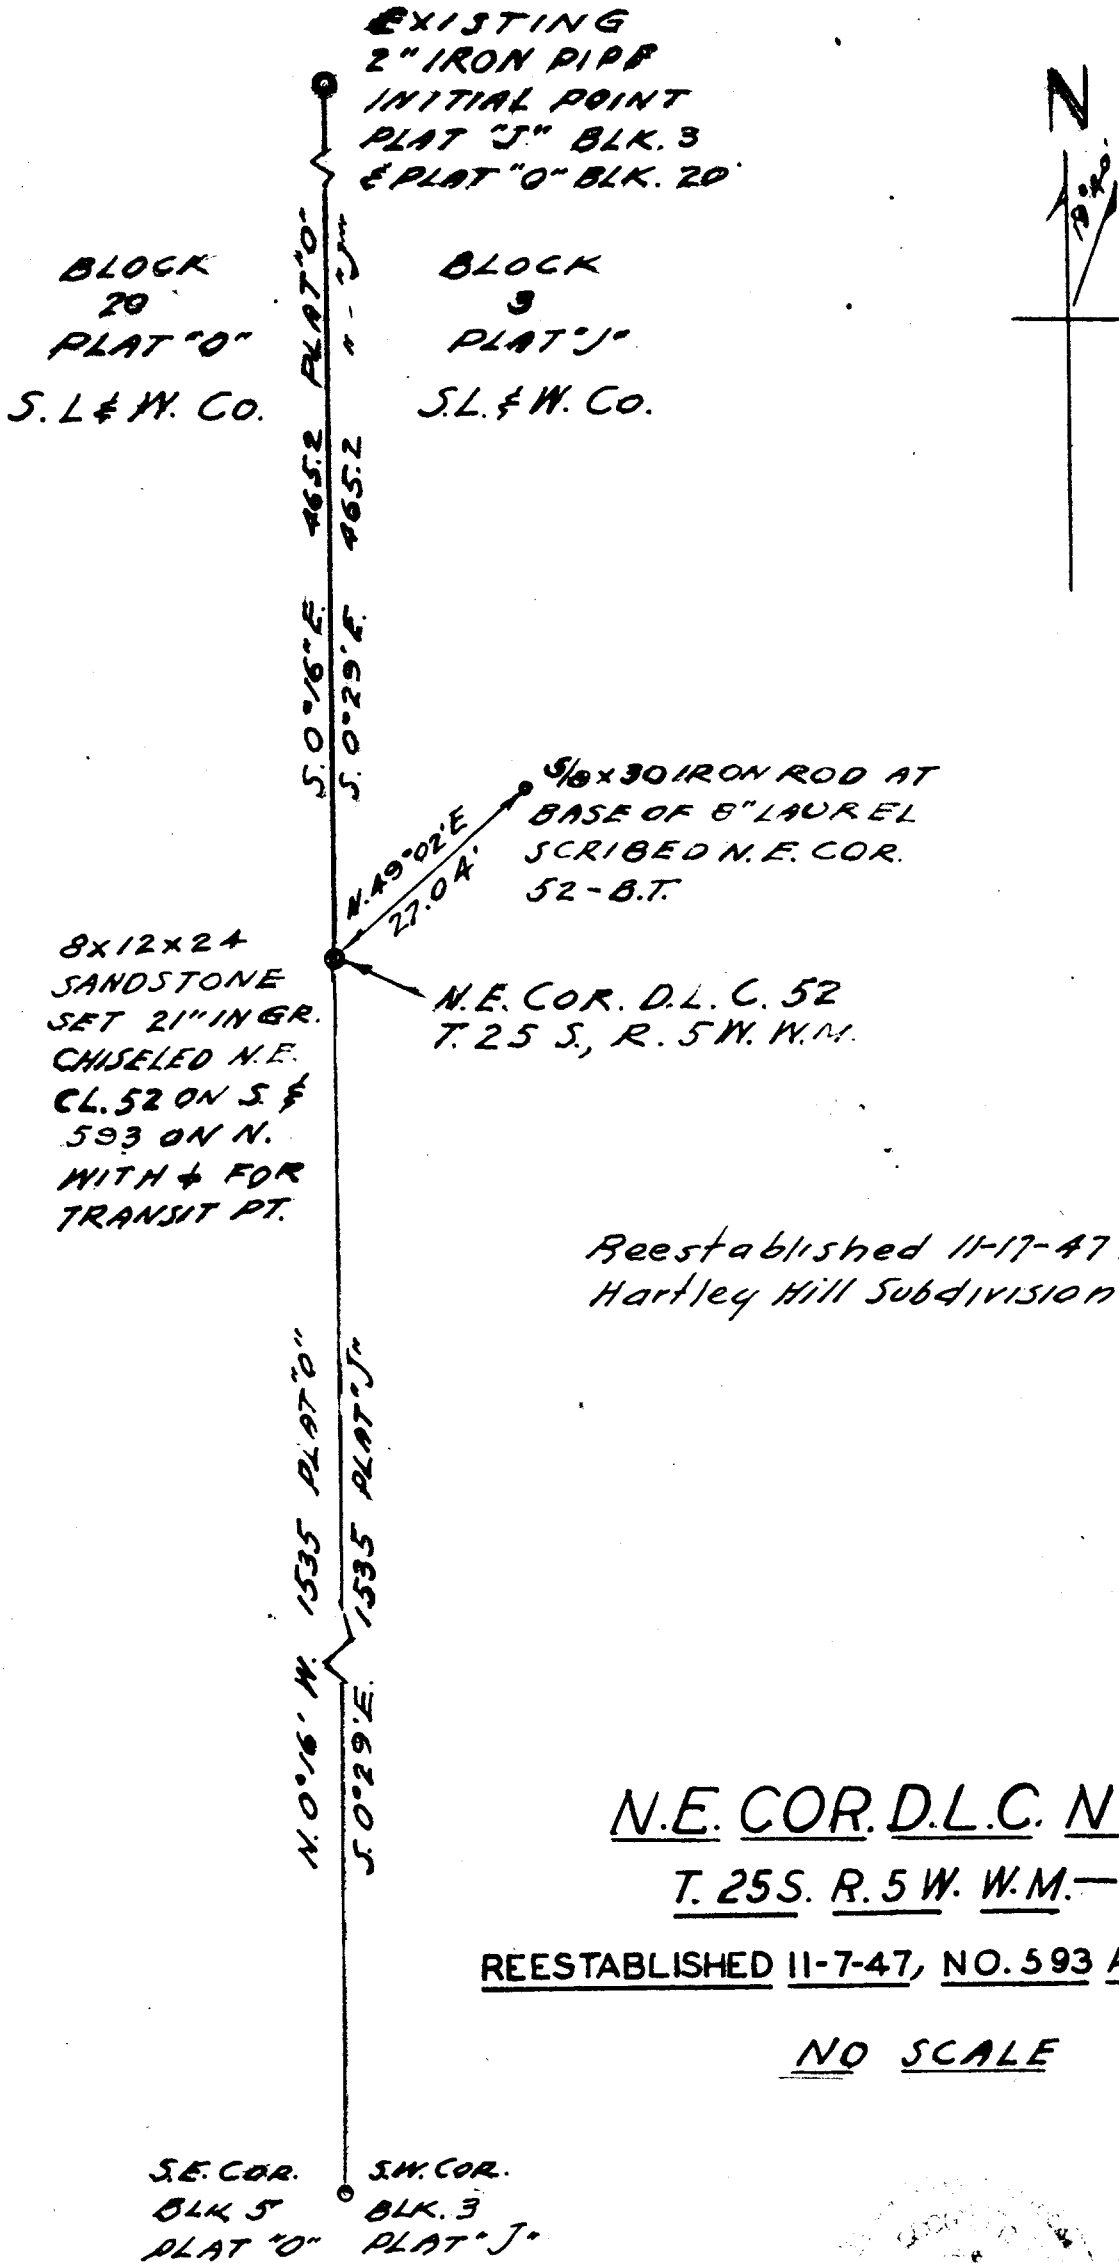

Reestablished 11-17-47 for Hartley Hill Subdivision

N.E. COR. D.L.C. NO. 52

T. 25 S. R. 5 W. W.M.—

REESTABLISHED 11-7-47, NO. 593 ADDED 7-7-48

NO SCALE

S.E. COR. S.W. COR.
 BLK 5 BLK. 3
 PLAT "O" PLAT "J"

Claude Mesner