

5-31-52

Section Corner 16-17-20-21, T30S,  
R3W, W. 1/4 as determined by  
O.B.T.s

A 30" dead fir snag bears  
S23 1/2 E, 35.0' dist. fd. scribe,  
and remarked S21.

At corner point set 1x30" I.P.  
from which

A Fir 36" diam. bears N66W, 111.0'  
dist. mkd. S17, B.T.


A La. 23" diam. bears N66E 53.0'  
dist. mkd. S16, 2880, T30S, R3W, B.T.

A Chip. 5" diam. bears S52W, 8.5'  
dist. mkd. S20, B.T.

A Maple 12" diam. bears S49W,  
43.0' dist. mkd. S20, B.T.

Corner lies on top of main  
ridge; Trail bears North 15.0'

Witness: Dennis Vaughan

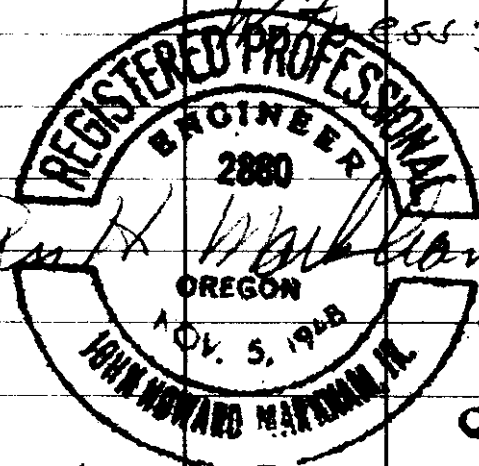

C. S. File No. 4152-3

Work done for Chapple Logging Co