

6-1-52

Renewal of a Renewal

Section Corner 4-5-8-9,  
T29S, R5W, W.M.

All 4 renewed bearing  
trees logged.

At corner point found  
wood post scribed and  
drove a 1x30" I.P.

from which

A La. 24" diam bears West  
60.0' dist. - this is an original  
B.T. fd scribed & remarked  
58, B.T.

A La. 24" diam bears N35W,  
107.0' dist. mkd. 55, B.T.

A Fir 24" diam bears N81°E,  
80.0' dist. mkd. 54, B.T.

A Maple 10" diam bears S71E,  
113.0' dist. mkd. 59, B.T.


Corner lies on North slope  
80' East of main side ridge.

The NW corner of Sec. 4  
can be seen from here and

bears N7½°W, 5514.0' dist.  
(Var. 20°00')

(OVER) CS 41/53-

Witness:  
Dennis Vaughn

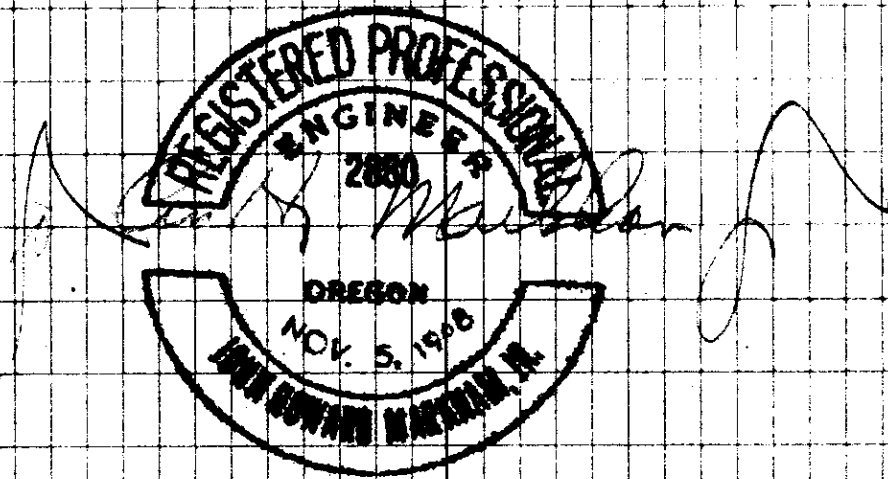

Work done for Stinson Lbr Co

**FILED**  
**RECEIVED**

**JUN 3 1952**

**COUNTY SURVEYOR**  
**DOUGLAS COUNTY, ORE.**

41-53