

East  $\frac{1}{4}$  corner between  
section 6-7, T30S, R2W, W.M.

A midpoint between the  
North  $\frac{1}{4}$  cor Sec. 7 and the  
N.E. cor Sec. 7, T30S, R2W,  
I drove a  $\frac{3}{4}$ " solid steel  
shaft.


from which  
A 1a. 10" diam. bears N85E,  
8.0' dist. mkd.  $\frac{1}{16}$ s B.T.  
A Sugar Pine 12" diam. bears  
N30°W 15.5' dist. mkd.  
 $\frac{1}{16}$ s B.T.

Witness:

J. F. Johnson

B. H. Johnson

Elmer Sutton

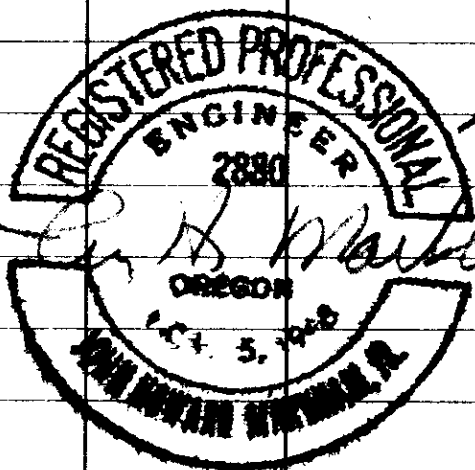

Work done for Elmer Sutton

4/14/32