

10-19-52

N.W. Corner Lot 1, Section
6, T29S, R5W, W.N.

At the midpoint on
Twp. Line between the
N.E. cor. and North $\frac{1}{4}$ cor.
Section 6, I drove a
 $\frac{1}{2}$ " x 20" I.P.
from which

A B.O. 18" diam. bears
N 45° W, 38.0' dist. mhd.
2880. $\frac{1}{16}$ S. B.T.

A B.O. 30" diam. bears
N 84° E 27.6' dist. mhd. $\frac{1}{16}$ S. B.T.
Road bears South 360.0' dist.

A Fence runs East + West
19.0' South of corner

$\frac{1}{4}$ cor. bears West 1334.0'

FILED cor. bears East 1334.0'

RECEIVED

Witness:
OCT 20 1952 W. T. Richardson


COUNTY SURVEYOR Gardner
DOUGLAS COUNTY, ORE.

Work done for Mrs. T. B. Richardson.

(OVER)

41-77

4/177

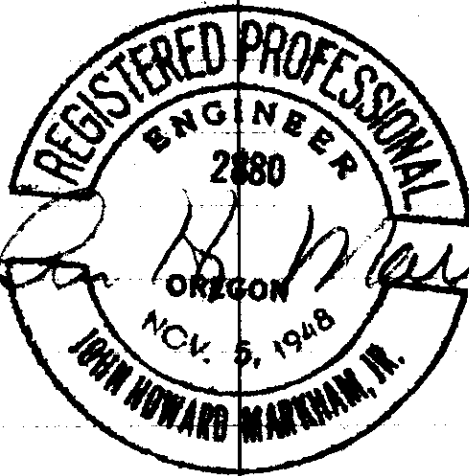

John H. Markham, Jr.