

10-16-52

S.W. Corner D.L.C. #41,
T305, R6W, W.M. as det. by
O.B.T.

A B.O. 20" diam. bears S25E,
73.0' dist. I found scribe.

At corner point I set
3/4" x 12" l. R.


from which
A W.O. 13" diam. bears N16°E,
60.5' dist. mkd. D.L.C. 41,
T305, R6W, B.T.

A W.O. 14" diam. bears S8°W,
92.5' dist. mkd. CL. 41, 2880, B.T.

There is a fence running North &
South from this corner.

Witness:

Harry Dayton

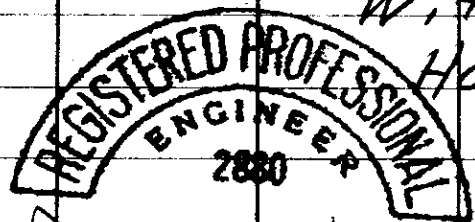

FILED
RECEIVED
JOURN HOWARD MARKHAM

OCT 20 1952

Work done COUNTY SURVEYOR
DOUGLAS COUNTY, OREGON

41578-3