





Orchard St.

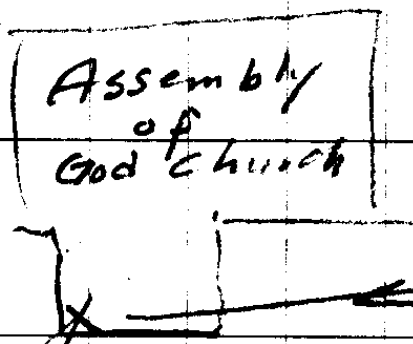

Accessories to
Sec Cor. 21, 22, 27 & 28
T29S, R5W.
in Myrtle Ck.

Cross on Conc.
porch of church.

Sec. Cor is under
4' of base rock.
Use Nail in pavement
Div. St.

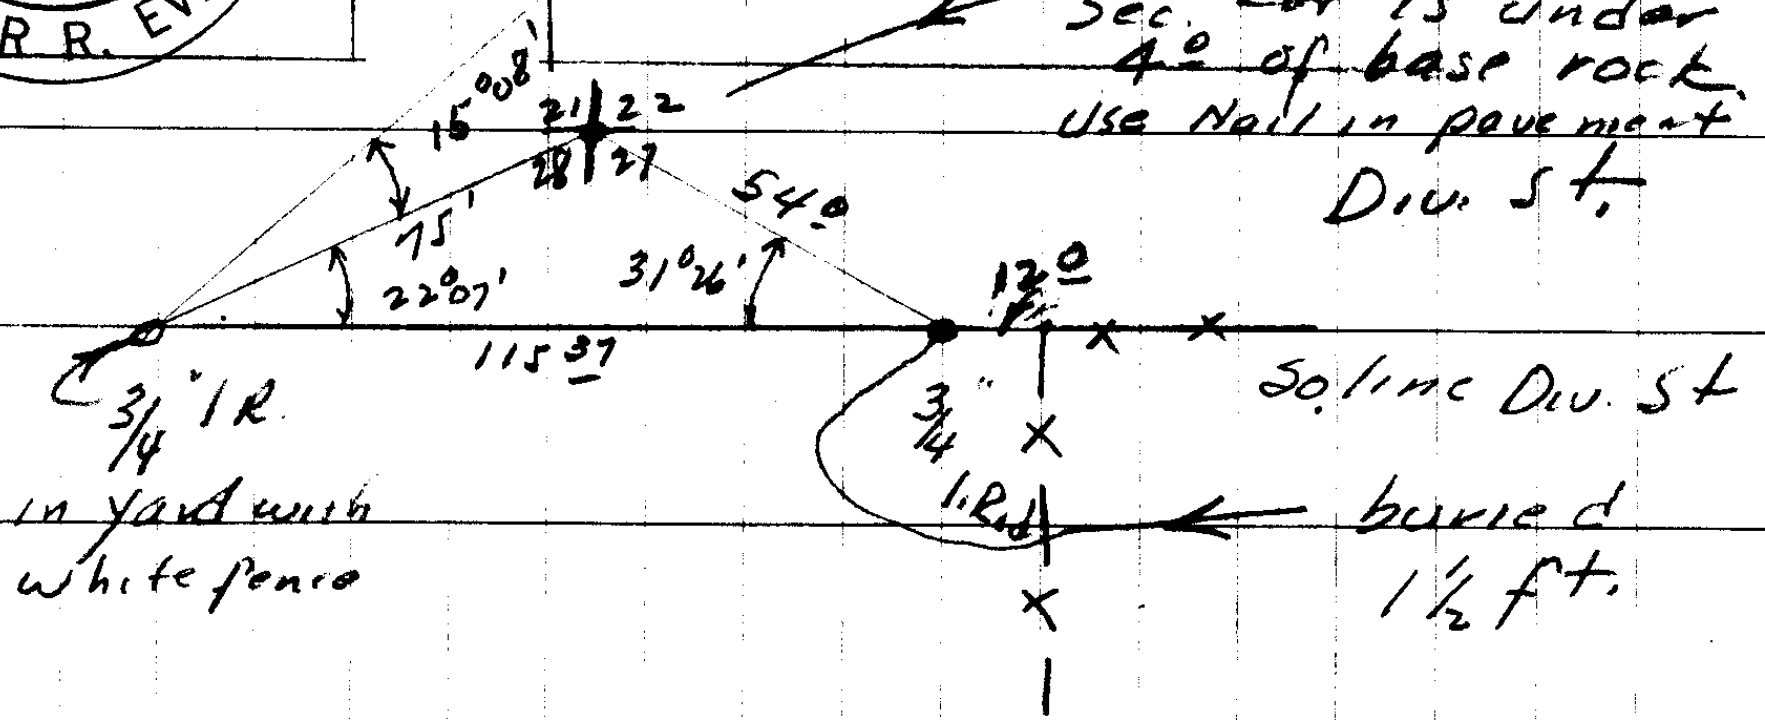

P.S. 4/1/41