

11-20-52

Center of Section 32,
T30S, R5W, W.N.

At the center of section
I set $3/4 \times 14$ " I.P.
from which

A W.O. 12" diam bears S70W, 37.0'
dist. mkd. $1/45$ c.c. B.T.

A W.O. 15" diam bears N50W,
56.0' dist. mkd. $1/45$ c.c. B.T.

Corner lies on east edge of private
road.

$\frac{1}{2}$ of County Road bears
North 680' distance.


Witness:

R.E. Proctor.

Work done for R.E. Proctor.

OVER

C. S. File No. 4182-2

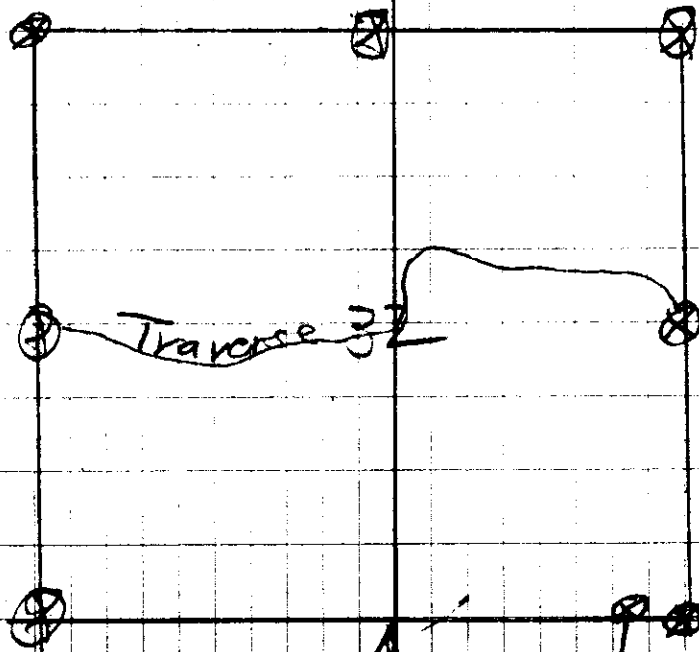

Not found
 ⊗ denotes corners found.

The E-N-W edge of section was chained around and a traverse run through middle as shown.

The [unclear] was calculated.



Hugh Howard Mortimer